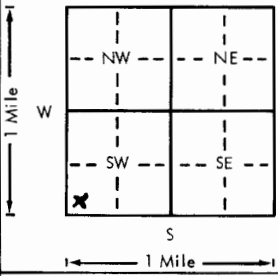
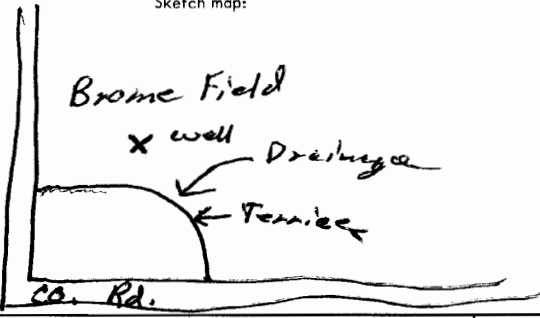


20

USE TYPEWRITER OR BALL
POINT PEN-PRESS FIRMLY,
PRINT CLEARLY.

WATER WELL RECORD
KSA 82a-1201-1215

Kansas Department of Health and
Environment-Division of Environment
(Water well Contractors)
Topeka, Kansas 66620

1. Location of well:		County Atchison	Fraction SW 1/4 SW 1/4 SW 1/4	Section number 9	Township number T 7 S	Range number R 18 E
2. Distance and direction from nearest town or city: 5 S 1 W		3. Owner of well: Paul Kelly		R.R. or street: RR #2		
Street address of well location if in city: Effingham		City, state, zip code: Effingham, KS 66023				
4. Locate with "X" in section below:		Sketch map:		6. Bore hole dia. 10 in. Completion date 9-1-78		
				Well depth 120 ft.		
5. Type and color of material		From	To	7. Cable tool <input checked="" type="checkbox"/> Rotary <input type="checkbox"/> Driven <input type="checkbox"/> Dug		
Top Soil		0	3	<input type="checkbox"/> Hollow rod <input type="checkbox"/> Jetted <input type="checkbox"/> Bored <input type="checkbox"/> Reverse rotary		
Yellow Clay		3	67	8. Use: <input type="checkbox"/> Domestic <input type="checkbox"/> Public supply <input type="checkbox"/> Industry		
Tan Silty Clay		67	75	<input type="checkbox"/> Irrigation <input type="checkbox"/> Air conditioning <input checked="" type="checkbox"/> Stock		
Yellow Fine Sand		75	83	<input type="checkbox"/> Lawn <input type="checkbox"/> Oil field water <input type="checkbox"/> Other		
Yellow Pea Gravel		83	90	9. Casing: Material PVC Height Above or below		
Blue Clay		90	91	Threaded <input type="checkbox"/> Welded <input type="checkbox"/> Surface 24 in.		
Gray Coarse & Cherty Gravel		91	93	RMP PVC Blue Weight 2.74 lbs./ft.		
Blue Clay		93	110	Dia. 5 in. to 120 ft. depth Wall Thickness: inches or		
Blue & Brown Chert Gravel		110	115	Dia. <input type="checkbox"/> in. to <input type="checkbox"/> ft. depth gage No. 1258		
Gray Clay		115	118	10. Screen: Manufacturer's name Pumped		
Gray Shale & Limestone		118	120	Type PVC Dia. 5 in.		
				Slot gauge 020 Length 40		
				Set between 80 ft. and 120 ft.		
				Gravel pack? <input checked="" type="checkbox"/> Size range of material 030/060		
				11. Static water level: 75 ft. below land surface Date 9-1-78		
				12. Pumping level below land surfaces: At test		
				<input type="checkbox"/> ft. after <input type="checkbox"/> hrs. pumping <input type="checkbox"/> g.p.m.		
				<input type="checkbox"/> ft. after <input type="checkbox"/> hrs. pumping <input type="checkbox"/> g.p.m.		
				Estimated maximum yield 40 g.p.m.		
				13. Water sample submitted: <input type="checkbox"/> Yes <input checked="" type="checkbox"/> No Date <input type="checkbox"/>		
				14. Well head completion: Top cap		
				<input type="checkbox"/> Pitless adapter <input type="checkbox"/> Inches above grade		
				15. Well grouted? yes		
				With: <input checked="" type="checkbox"/> Neat cement <input type="checkbox"/> Bentonite <input type="checkbox"/> Concrete		
				Depth: From 0 ft. to 10 ft.		
				16. Nearest source of possible contamination: Brome		
				ft. <input type="checkbox"/> Direction located in field Type located in field		
				Well disinfected upon completion? <input checked="" type="checkbox"/> Yes <input type="checkbox"/> No		
				17. Pump: <input checked="" type="checkbox"/> Not installed		
				Manufacturer's name <input type="checkbox"/>		
				Model number <input type="checkbox"/> HP <input type="checkbox"/> Volts <input type="checkbox"/>		
				Length of drop pipe <input type="checkbox"/> ft. capacity <input type="checkbox"/> g.p.m.		
				Type: <input type="checkbox"/> Submersible <input type="checkbox"/> Turbine		
				<input type="checkbox"/> Jet <input type="checkbox"/> Reciprocating		
				<input type="checkbox"/> Centrifugal <input type="checkbox"/> Other		
18. Elevation: 1080		19. Remarks: owner to install slab		20. Water well contractor's certification:		
Topography: 1083 NW				This well was drilled under my jurisdiction and this report		
<input type="checkbox"/> Hill <input type="checkbox"/> Slope <input checked="" type="checkbox"/> Upland <input type="checkbox"/> Valley				is true to the best of my knowledge and belief.		
				Strader Dale G 182		
				Business name <input type="checkbox"/> License No. <input type="checkbox"/>		
				Address PT 1 Holton, KS		
				Signed Dale Strader Date 9-2-78		
				Authorized representative		