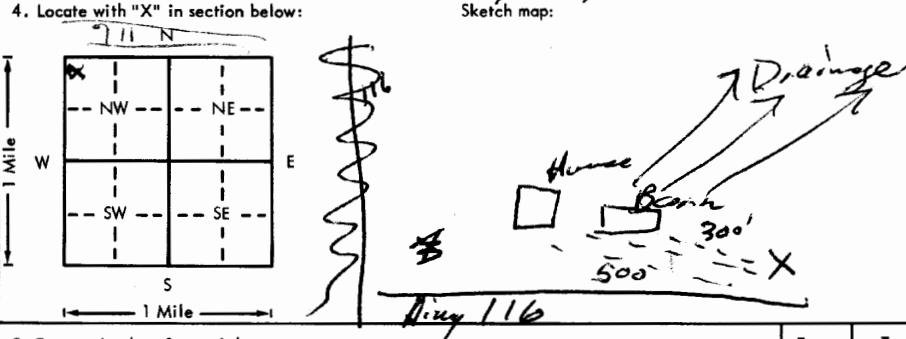


USE TYPEWRITER OR BALL  
POINT PEN-PRESS FIRMLY,  
PRINT CLEARLY.

WATER WELL RECORD  
KSA 82a-1201-1215

Kansas Department of Health and  
Environment-Division of Environment  
(Water well Contractors)  
Topeka, Kansas 66620

1. Location of well: County <u>Atchison</u> Fraction <u>N.W. 1/4 N.W. 1/4 N.W. 1/4</u> Section number <u>11</u> Township number <u>T 7 S</u> Range number <u>R 18 E</u>	
2. Distance and direction from nearest town or city: <u>3 1/2 South + 1 1/4 E. from Effingham, KS.</u> 3. Owner of well: <u>Sam Bingham</u> R.R. or street: <u>Rt. #1</u> City, state, zip code: <u>Nortonville, KS.</u>	
4. Locate with "X" in section below: Sketch map: 	
5. Type and color of material	
6. Bore hole dia. <u>8</u> in. Completion date <u>7-12-76</u> Well depth <u>100</u> ft.	
7. Cable tool <input checked="" type="checkbox"/> Rotary <input type="checkbox"/> Driven <input type="checkbox"/> Dug <input type="checkbox"/> Hollow rod <input type="checkbox"/> Jetted <input type="checkbox"/> Bored <input type="checkbox"/> Reverse rotary	
8. Use: <input checked="" type="checkbox"/> Domestic <input type="checkbox"/> Public supply <input type="checkbox"/> Industry <input type="checkbox"/> Irrigation <input type="checkbox"/> Air conditioning <input checked="" type="checkbox"/> Stock <input type="checkbox"/> Lawn <input type="checkbox"/> Oil field water <input type="checkbox"/> Other	
9. Casing: Material <u>PVC</u> Height: <u>Above or below</u> Threaded <input type="checkbox"/> Welded <input type="checkbox"/> Surface <u>24</u> in. RMP <u>PVC 31/2</u> Weight <u>2.75</u> lbs./ft. Dia. <u>5</u> in. to <u>100</u> ft. depth Wall Thickness: inches or Dia. <u>5</u> in. to <u>100</u> ft. depth gage No. <u>1230</u>	
10. Screen: Manufacturer's name <u>Purplex</u> Type <u>PVC</u> Dia. <u>5"</u> Slot/gauze <u>30</u> Length <u>30</u> Set between <u>70</u> ft. and <u>100</u> ft. Gravel pack? <input checked="" type="checkbox"/> Size range of material <u>8x14</u>	
11. Static water level: <u>50</u> ft. below land surface Date <u>7-12-76</u> mo./day/yr.	
12. Pumping level below land surfaces: <u>Air Test</u> <u>50</u> ft. after <u>0</u> hrs. pumping <u>0</u> g.p.m. <u>50</u> ft. after <u>0</u> hrs. pumping <u>0</u> g.p.m. Estimated maximum yield <u>15</u> g.p.m.	
13. Water sample submitted: <u>Yes</u> <input checked="" type="checkbox"/> No <input type="checkbox"/> Date <u>7-12-76</u> mo./day/yr.	
14. Well head completion: <u>Capped</u> <u>24</u> Pitless adapter <u>24</u> inches above grade	
15. Well grouted? <input checked="" type="checkbox"/> With: <u>Neat cement</u> <input type="checkbox"/> Bentonite <input checked="" type="checkbox"/> Concrete <input type="checkbox"/> Depth: From <u>0</u> ft. to <u>10</u> ft.	
16. Nearest source of possible contamination: ft. <u>300</u> Direction <u>E</u> Type <u>LOT</u> Well disinfected upon completion? <input checked="" type="checkbox"/> Yes <input type="checkbox"/> No	
17. Pump: <u>Not installed</u> Manufacturer's name _____ Model number _____ HP _____ Volts _____ Length of drop pipe _____ ft. capacity _____ g.p.m. Type: _____ <input type="checkbox"/> Submersible <input type="checkbox"/> Turbine <input type="checkbox"/> Jet <input type="checkbox"/> Reciprocating <input type="checkbox"/> Centrifugal <input type="checkbox"/> Other	
18. Elevation: <u>970</u> Topography: <u>Hill</u> <input checked="" type="checkbox"/> Hill <input type="checkbox"/> Slope <input type="checkbox"/> Upland <input type="checkbox"/> Valley	
19. Remarks: <u>I will put a cement slab around the well</u> <u>Sam Bingham</u>	
20. Water well contractor's certification: This well was drilled under my jurisdiction and this report is true to the best of my knowledge and belief. <u>Strader Dalg Co Inc 182</u> Business name _____ License No. _____ Address <u>RT 1 Horton, KS</u> Signed <u>Dale Ackerson</u> Date <u>7-13-76</u> Authorized representative	

Forward the white, blue and pink copies to the Department of Health and Environment

Form WWC-5