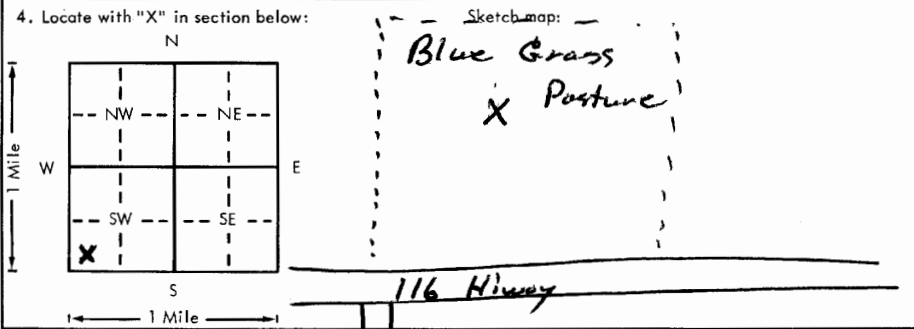


USE TYPEWRITER OR BALL
POINT PEN-PRESS FIRMLY,
PRINT CLEARLY.

WATER WELL RECORD
KSA 82a-1201-1215

Kansas Department of Health and
Environment-Division of Environment
(Water well Contractors)
Topeka, Kansas 66620

CCC

1. Location of well:		County Hickson	Fraction SW 1/4 SW 1/4 SW 1/4	Section number 84	Township number T 7 S R 19 E/W	Range number
2. Distance and direction from nearest town or city: 3 N 1 E			3. Owner of well: Jack Cannon R.R. or street: RR City, state, zip code: Nortonville, Ks. 66060			
Street address of well location if in city: Nortonville						
4. Locate with "X" in section below: 			6. Bore hole dia. 10 in. Completion date 6-9-78 Well depth 101 ft.			
			7. Cable tool <input checked="" type="checkbox"/> Rotary <input type="checkbox"/> Driven <input type="checkbox"/> Dug <input type="checkbox"/> Hollow rod <input type="checkbox"/> Jetted <input type="checkbox"/> Bored <input type="checkbox"/> Reverse rotary			
			8. Use: <input checked="" type="checkbox"/> Domestic <input type="checkbox"/> Public supply <input type="checkbox"/> Industry <input type="checkbox"/> Irrigation <input type="checkbox"/> Air conditioning <input type="checkbox"/> Stock <input type="checkbox"/> Lawn <input type="checkbox"/> Oil field water <input type="checkbox"/> Other			
			9. Casing: Material PVC Height Above or below Threaded <input type="checkbox"/> Welded <input type="checkbox"/> Surface 24 in. RMP PVC Glue Weight 2.24 lbs./ft. Dia. 5 in. to 101 ft. depth Wall Thickness: inches or Dia. <input type="checkbox"/> in. to <input type="checkbox"/> ft. depth Gauge No. 258			
5. Type and color of material			From	To	10. Screen: Manufacturer's name Pumped Type PVC Dia. 5 in. Gauge 020 Length 30 ft. Set between 20 ft. and 40 ft. 85 ft. and 95 ft. Gravel pack? YES Size range of material 030/60	
Top Soil			0	7	11. Static water level: 20 ft. below land surface Date 6-9-78	
Tan Clay			7	16	12. Pumping level below land surfaces: Air test ft. after <input type="checkbox"/> hrs. pumping <input type="checkbox"/> g.p.m. ft. after <input type="checkbox"/> hrs. pumping <input type="checkbox"/> g.p.m. Estimated maximum yield 6 g.p.m.	
Yellow Clay Sandy			16	25	13. Water sample submitted: <input checked="" type="checkbox"/> Yes <input type="checkbox"/> No Date	
Yellow Gravelly Clay			25	30	14. Well head completion: Top Cap Pitless adapter 24 inches above grade	
Brown Cherty Gravel			30	33	15. Well grouted? YES With: <input checked="" type="checkbox"/> Neat cement <input type="checkbox"/> Bentonite <input type="checkbox"/> Concrete Depth: From 0 ft. to 10 ft.	
Yellow Clay			33	65	16. Nearest source of possible contamination: * ft. Direction Type Well disinfected upon completion? <input checked="" type="checkbox"/> Yes <input type="checkbox"/> No	
Gray Clay			65	88	17. Pump: <input checked="" type="checkbox"/> Not installed Manufacturer's name Model number HP Volts Length of drop pipe ft. capacity g.p.m. Type: <input type="checkbox"/> Submersible <input type="checkbox"/> Turbine <input type="checkbox"/> Jet <input type="checkbox"/> Reciprocating <input type="checkbox"/> Centrifugal <input type="checkbox"/> Other	
Gray Sandy Clay			88	91		
Gray Clay			91	101		
(Use a second sheet if needed)						
18. Elevation: 1112 Topography: <input type="checkbox"/> Hill <input type="checkbox"/> Slope <input checked="" type="checkbox"/> Upland <input type="checkbox"/> Valley		19. Remarks: Owner to install slab #16 well in Bluegrass Pasture		20. Water well contractor's certification: This well was drilled under my jurisdiction and this report is true to the best of my knowledge and belief. STADER DAIG CO License No. 182 Business name Address RT 1 Horton, Ks Signed Dale Ashburn Date 6-28-78 Authorized representative		

Forward the white, blue and pink copies to the Department of Health and Environment

Form WWC-5