

42

'adb

2-3-77 + 1  
13-  
VIRT

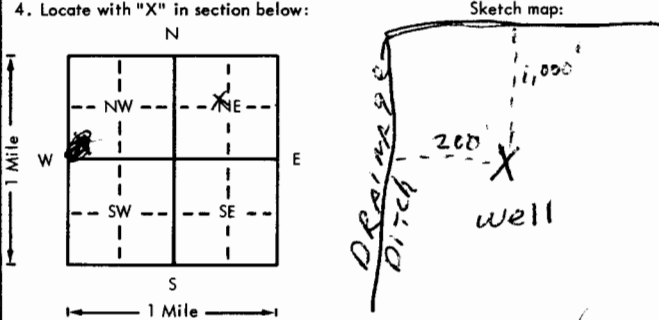
USE TYPEWRITER OR BALL POINT PEN-PRESS FIRMLY, PRINT CLEARLY.

700'

WATER WELL RECORD  
KSA 82a-1201-1215

Kansas Department of Health and Environment-Division of Environment  
(Water well Contractors)  
Topeka, Kansas 66620

NW SE NE 32 7

1. Location of well: County: <u>JEFFERSON</u>		Fraction: <u>SE NW NE</u> <u>SW 1/4 SW 1/4 NW 1/4</u>		Section number: <u>32</u>	Township number: <u>T 9 S</u>	Range number: <u>R 19 E/W</u>
2. Distance and direction from nearest town or city: <u>.5 E 1.55</u> Street address of well location if in city: <u>.5 E OF NORTONVILLE</u>			3. Owner of well: <u>JEFFERSON CO. RWD #12</u> R.R. or street: <u>NORTONVILLE (66060)</u> City, state, zip code:			
4. Locate with "X" in section below: 			6. Bore hole dia. <u>8</u> in. Completion date _____ Well depth <u>110</u> ft. <u>2-16-76</u>			
			7. <input checked="" type="checkbox"/> Cable tool <input checked="" type="checkbox"/> Rotary <input type="checkbox"/> Driven <input type="checkbox"/> Dug <input type="checkbox"/> Hollow rod <input type="checkbox"/> Jetted <input type="checkbox"/> Bored <input type="checkbox"/> Reverse rotary			
			8. Use: <input type="checkbox"/> Domestic <input checked="" type="checkbox"/> Public supply <input type="checkbox"/> Industry <input type="checkbox"/> Irrigation <input type="checkbox"/> Air conditioning <input type="checkbox"/> Stock <input type="checkbox"/> Lawn <input type="checkbox"/> Oil field water <input type="checkbox"/> Other			
			9. Casing: Material <u>STEEL</u> Height: <u>Above</u> or below Threaded _____ Welded <input checked="" type="checkbox"/> Surface <u>24</u> in. <u>40.48</u> RMP _____ PVC _____ Weight <u>2.74</u> lbs./ft. Dia. <u>10</u> in. to <u>110</u> ft. depth Wall Thickness: inches or <u>3.65</u> Dia. _____ in. to _____ ft. depth gage No. <u>258</u>			
5. Type and color of material			From	To	10. Screen: Manufacturer's name _____ <u>JOHNSON</u> Type <u>STAINLESS STEEL</u> Dia. <u>10"</u> Slot/gauze <u>20</u> Length <u>16'</u> Set between <u>90</u> ft. and <u>106</u> ft. ft. and _____ ft. Gravel pack? <input checked="" type="checkbox"/> Size range of material <u>C30-L60</u>	
<u>TOP SOIL</u>			<u>0</u>	<u>4</u>	11. Static water level: _____ mo./day/yr. <u>80</u> ft. below land surface Date <u>2-16-76</u>	
<u>yellow clay</u>			<u>4</u>	<u>79</u>	12. Pumping level below land surfaces: <u>88</u> ft. after <u>24</u> hrs. pumping <u>150</u> g.p.m. _____ ft. after _____ hrs. pumping _____ g.p.m. Estimated maximum yield <u>1200</u> g.p.m.	
<u>Blue clay</u>			<u>79</u>	<u>107</u>	13. Water sample submitted: _____ mo./day/yr. <input checked="" type="checkbox"/> Yes <input type="checkbox"/> No Date <u>2-16-76</u>	
<u>WATER BEARING FINE SAND - COURSE SAND</u>			<u>107</u>	<u>112</u>	14. Well head completion: <input checked="" type="checkbox"/> Pitless adapter <u>36</u> Inches above grade	
<u>COURSE SAND - MEDIUM GRAVEL</u>			<u>112</u>	<u>118</u>	15. Well grouted? <input checked="" type="checkbox"/> With: <input checked="" type="checkbox"/> Neat cement <input type="checkbox"/> Bentonite <input type="checkbox"/> Concrete Depth: From <u>0</u> ft. to <u>40</u> ft.	
<u>COURSE SAND - MEDIUM GR - FEA GRAVEL</u>			<u>118</u>	<u>129</u>	16. Nearest source of possible contamination: ft. <u>1000</u> Direction <u>N-W</u> Type <u>DRAINAGE</u> Well disinfected upon completion? <input checked="" type="checkbox"/> Yes <input type="checkbox"/> No	
<u>FINE SAND - yellow</u>			<u>129</u>	<u>137</u>	17. Pump: _____ Not installed Manufacturer's name <u>JACOZZI</u> Model number <u>262608-T2HP</u> Volts <u>460</u> Length of drop pipe <u>105'</u> ft. capacity <u>200</u> g.p.m. Type: <input checked="" type="checkbox"/> Submersible <input type="checkbox"/> Turbine <input type="checkbox"/> Jet <input type="checkbox"/> Reciprocating <input type="checkbox"/> Centrifugal <input type="checkbox"/> Other	
<u>shale - grey</u>			<u>137</u>	<u>140</u>		
			(Use a second sheet if needed)			
18. Elevation: <u>1130</u> Topography: <input checked="" type="checkbox"/> Hill <input type="checkbox"/> Slope <input type="checkbox"/> Upland <input type="checkbox"/> Valley		19. Remarks: <u>6x6x6 slab installed</u>		20. Water well contractor's certification: This well was drilled under my jurisdiction and this report is true to the best of my knowledge and belief. <u>Strader Dely Co Inc</u> 182 Business name License No. _____ Address <u>PT 1 Holton, KS</u> Signed <u>Dale Casper</u> Date <u>2-16-76</u> Authorized representative		

40.48  
3.65  
1-10  
R 19 E  
Sec 32  
SWSW

BR elev = 993