


1	LOCATION OF WATER WELL:	Fraction <u>SE</u>	Section Number	Township Number	Range Number
	County: <u>JEFFERSON</u>	<u>1/4</u> 1/4 1/4	<u>30</u>	<u>NORTON</u> <u>7</u>	<u>19</u>

Distance and direction from nearest town or city street address of well if located within city?  
DN ELM ST NEXT TO 403 OSAGE ST.

2 WATER WELL OWNER: CITY OF NORTONVILLE KS 913 886 2060  
 RR #, St. Address, Box #: P.O. Box 177  
 City, State, ZIP Code: NORTONVILLE KS 66060  
 Board of Agriculture, Division of Water Resources  
 Application Number: PWS R-2500

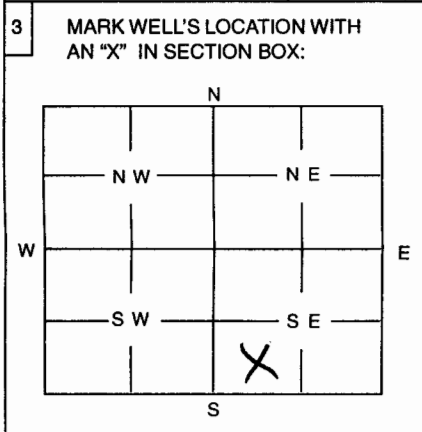

4 DEPTH OF WELL ..... 156 ..... ft.  
 WELL'S STATIC WATER LEVEL ..... 6.9 ..... ft.  
 WELL WAS USED AS:  
 1 Domestic  5 Public Water Supply  9 Dewatering   
 2 Irrigation  6 Oil Field Water Supply  10 Monitoring Well   
 3 Feedlot  7 Domestic (Lawn & Garden)  11 Injection Well   
 4 Industrial  8 Air Conditioning  12 Other .....   
 Was a chemical / bacteriological sample submitted to Department? Yes ..... No   
 If yes, mo/day/yr sample was submitted .....  
 Water Well Disinfected: Yes  No .....

5 TYPE OF BLANK CASING USED:  
 1 Steel  3 RMP (SR)  5 Wrought  7 Fiberglass  9 Other (Specify below)  
 2 PVC  4 ABS  6 Asbestos-Cement  8 Concrete Tile .....  
 Blank casing diameter 6 in. Was casing pulled? Yes  No ..... If yes, how much 53"  
 Casing height above or below land surface 48 in.

6 GROUT PLUG MATERIAL: 1 Neat cement 2 Cement grout  3 Bentonite 4 Other .....  
 Grout Plug Intervals: From ..... ft. to ..... ft., From ..... ft. to ..... ft., From ..... to ..... ft.  
 What is the nearest source of possible contamination:  
 1 Septic tank  6 Seepage pit  11 Fuel storage  16 Other (specify below)  
 2 Sewer lines  7 Pit privy  12 Fertilizer storage  
 3 Watertight sewer lines  8 Sewage lagoon  13 Insecticide storage  
 4 Lateral lines  9 Feedyard  14 Abandoned water well  
 5 Cess Pool  10 Livestock pens  15 Oil well/Gas well  
 Direction from well? EAST How many feet? 1000 FT +

FROM	TO	PLUGGING MATERIALS
<u>156'</u>	<u>1'</u>	<u>SAND</u>
<u>1'</u>	<u>2' ABOVE CASING</u>	<u>BENTONITE 2' ABOVE CASING</u>
<u>2' ABOVE CASING</u>	<u>GROUND LEVEL</u>	<u>CLAY AND BLACK DIRT 3' OR BETTER DEEP</u>

7 CONTRACTOR'S OR LANDOWNER'S CERTIFICATION: This water well was plugged under my jurisdiction and was completed on (mo/day/year) Dec. 13 2005 and this record is true to the best of my knowledge and belief. Kansas Water Well Contractor's License No. Smith's Sewer and Repair This Water Well Record was completed on (mo/day/year) Dec. 13 2005 under the business name of Smith's Sewer and Repair by (signature) Francis Schmidt

INSTRUCTIONS: Use typewriter or ball point pen. Please press firmly and print clearly. Please fill in blanks, underline or circle the correct answers. Send top three copies to Kansas Department of Health and Environment, Bureau of Water, Topeka, Kansas 66620-0001. Telephone: 785/296-3565. Send one to Water Well Owner and retain one for your records.