

WATER WELL RECORD

NSA 82a-1212

1103


1 LOCATION OF WATER WELL: Fraction 20 1/4 NW 1/4 SW 1/4 Section Number 29 Township Number T 7 S Range Number R 19 EW
 County: JEFFERSON

Distance and direction from nearest town or city street address of well if located within city?
HWY 4-59 OLD JUNCT - S OF NORTONVILLE KS

2 WATER WELL OWNER: COUNTRY INN SERVICE ATT ROBERT LEFLET

RR#, St. Address, Box # : NORTONVILLE KS - 66060 Board of Agriculture, Division of Water Resources
 City, State, ZIP Code RR 1 - 186A Application Number:

3 LOCATE WELL'S LOCATION WITH AN "X" IN SECTION BOX: 4 DEPTH OF COMPLETED WELL 20 ft. ELEVATION: 14 ft.
 Depth(s) Groundwater Encountered 1. 14 ft. 2. - ft. 3. - ft.

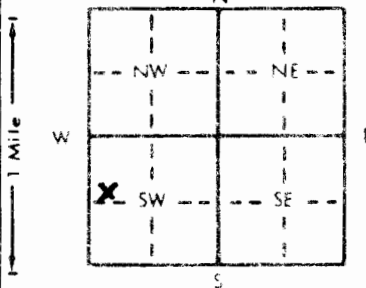

WELL'S STATIC WATER LEVEL 9.68 ft. below land surface measured on mo/day/yr 07-07-94
 Pump test data. Well water was - ft. after - hours pumping - gpm
 Est. Yield - gpm; Well water was - ft. after - hours pumping - gpm

Bore Hole Diameter. 8.625 in. to 20 ft. and - in. to - ft.

WELL WATER TO BE USED AS:
 1 Domestic 3 Feedlot 6 Oil field water supply 9 Dewatering 12 Other (Specify below)
 2 Irrigation 4 Industrial 7 Lawn and garden only 10 Monitoring well

Was a chemical bacteriological sample submitted to Department? Yes No If yes, mo/day/yr sample was submitted -
 Water Well Disinfected? Yes No

5 TYPE OF BLANK CASING USED:
 1 Steel 3 RMP (SR) 5 Wrought iron 8 Concrete tile CASING JOINTS: Glued Clamped
 2 PVC 4 ABS 6 Asbestos-Cement 9 Other (specify below) Welded
 7 Fiberglass Threaded

Blank casing diameter 2 in. to 10 ft. Dia. - in. to - ft. Dia. - in. to - ft.
 Casing height above land surface 24 in. weight SCH 40 lbs./ft. Wall thickness or gauge No. -

TYPE OF SCREEN OR PERFORATION MATERIAL:
 1 Steel 3 Stainless steel 5 Fiberglass 7 PVC 10 Asbestos-cement
 2 Brass 4 Galvanized steel 6 Concrete tile 8 RMP (SR) 11 Other (specify)
 9 ABS 12 None used (open hole)

SCREEN OR PERFORATION OPENINGS ARE:
 1 Continuous slot 3 Mill slot 5 Gauzed wrapped 8 Saw cut 11 None (open hole)
 2 Louvered shutter 4 Key punched 6 Wire wrapped 9 Drilled holes

SCREEN-PERFORATED INTERVALS: From - ft. to 20 ft. From - ft. to - ft.
 From - ft. to - ft. From - ft. to - ft.

SAND GRAVEL PACK INTERVALS: From 9 ft. to 20 ft. From - ft. to - ft.
 From - ft. to - ft. From - ft. to - ft.

6 GROUT MATERIAL: 1 Neat cement 2 Cement grout 3 Bentonite 4 Other
 Grout Intervals: From 2 ft. to 7 ft. From 7 ft. to 7 ft. From - ft. to - ft.

What is the nearest source of possible contamination:
 1 Septic tank 4 Lateral lines 7 Pit privy 10 Livestock pens 14 Abandoned water well
 2 Sewer lines 5 Cess pool 6 Sewage lagoon 11 Fuel storage 15 Oil well/Gas well
 3 Watertight sewer lines 6 Seepage pit 9 Feedyard 12 Fertilizer storage 16 Other (specify below) CONTAMINATED SITE

Direction from well? - How many feet? -

FROM	TO	LITHOLOGIC LOG	FROM	TO	PLUGGING INTERVALS
<u>6L</u>	<u>2</u>	<u>SOIL SILTY CLAY</u>			
<u>2</u>	<u>20</u>				
<u>TD</u>	<u>20</u>				

7 CONTRACTOR'S OR LANDOWNER'S CERTIFICATION: This water well was (1) constructed, (2) reconstructed, or (3) plugged under my jurisdiction and was completed on (mo/day/year) 07-05-94 and this record is true to the best of my knowledge and belief. Kansas Water Well Contractor's License No. 479 This Water Well Record was completed on (mo/day/yr) 07-20-94 under the business name of EBBERTS DRILLING by (signature) Angela Ebberts

INSTRUCTIONS: Use typewriter or ball point pen. PLEASE PRESS FIRMLY and PRINT clearly. Please fill in blanks, underline or circle the correct answers. Send top three copies to Kansas Department of Health and Environment, Bureau of Water, Topeka, Kansas 66620-0001. Telephone 913-296-5545. Send one to WATER WELL OWNER and retain one for your records.