


MW 4

1 LOCATION OF WATER WELL: Fraction SW 1/4 NW 1/4 SW 1/4 Section Number 29 Township Number T 7 S Range Number R 19 EW
 County: JEFFERSON

Distance and direction from nearest town or city street address of well if located within city?
Hwy 4 + 59 Old Junct - S of Nortonville KS

2 WATER WELL OWNER: COUNTRY INN SERVICE - ATT ROBERT LEFLET
 RR#, St. Address, Box #: RR1 - 196A NORTONVILLE KS - 66664
 City, State, ZIP Code: RR1 - 196A NORTONVILLE KS - 66664 Board of Agriculture, Division of Water Resources
 Application Number:

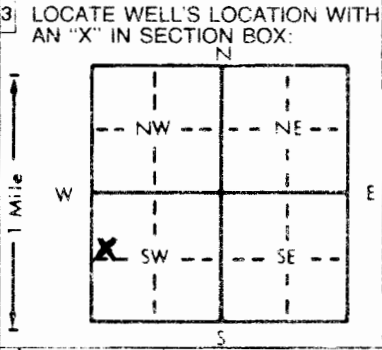

4 DEPTH OF COMPLETED WELL: 20 ft. ELEVATION:
 Depth(s) Groundwater Encountered: 10.51/4 ft. 2. - ft. 3. - ft.
 WELL'S STATIC WATER LEVEL: 10.51/4 ft. below land surface measured on mo/day/yr 07-07-94
 Pump test data: Well water was - ft. after - hours pumping - gpm
 Est. Yield - gpm: Well water was - ft. after - hours pumping - gpm
 Bore Hole Diameter: 8.625 in. to 20 ft., and - in. to - ft.
 WELL WATER TO BE USED AS:
 1 Domestic - 3 Feedlot - 6 Oil field water supply - 9 Dewatering - 12 Other (Specify below)
 2 Irrigation - 4 Industrial - 7 Lawn and garden only 10 Monitoring well
 Was a chemical/bacteriological sample submitted to Department? Yes - No X if yes, mo/day/yr sample was submitted -
 Water Well Disinfected? Yes - No X

5 TYPE OF BLANK CASING USED:
 1 Steel 2 PVC 3 RMP (SR) 4 ABS 5 Wrought iron 6 Asbestos-Cement 7 Fiberglass 8 Concrete tile 9 Other (specify below) 10 Asbestos-cement
 Blank casing diameter: 2 in. to 8 ft. Dia. - in. to - ft. Dia. - in. to - ft.
 Casing height above land surface: 24 in. weight SCH 70 lbs. ft. Wall thickness or gauge No. -
 TYPE OF SCREEN OR PERFORATION MATERIAL:
 1 Steel 2 Brass 3 Stainless steel 4 Galvanized steel 5 Fiberglass 6 Concrete tile 7 PVC 8 RMP (SR) 9 ABS 10 Asbestos-cement 11 Other (specify) - 12 None used (open hole)
 SCREEN OR PERFORATION OPENINGS ARE:
 1 Continuous slot 2 Louvered shutter 3 Mill slot 4 Key punched 5 Gauzed wrapped 6 Wire wrapped 7 Torch cut 8 Saw cut 9 Drilled holes 11 None (open hole)
 SCREEN-PERFORATED INTERVALS: From 8 ft. to 18 ft. From - ft. to - ft. From - ft. to - ft.
~~SAND~~ ~~GRAVEL~~ PACK INTERVALS: From 7 ft. to 20 ft. From - ft. to - ft. From - ft. to - ft.

6 GROUT MATERIAL: 1 Neat cement 2 GL Cement grout 3 S Bentonite 4 Other -
 Grout Intervals: From GL ft. to S ft. From 5 ft. to 7 ft. From - ft. to - ft.
 What is the nearest source of possible contamination:
 1 Septic tank 2 Sewer lines 3 Watertight sewer lines 4 Lateral lines 5 Cess pool 6 Seepage pit 7 Pit privy 8 Sewage lagoon 9 Feedyard 10 Livestock pens 11 Fuel storage 12 Fertilizer storage 13 Insecticide storage 14 Abandoned water well 15 Oil well/Gas well 16 Other (specify below) CONTAMINATED SITE
 Direction from well? - How many feet? -

FROM	TO	LITHOLOGIC LOG	FROM	TO	PLUGGING INTERVALS
<u>GL</u>	<u>2</u>	<u>SOIL SILTY CLAY</u>			
<u>2</u>	<u>20</u>				
<u>TD</u>	<u>20</u>				
		<u>FLUSH</u>			

7 CONTRACTOR'S OR LANDOWNER'S CERTIFICATION: This water well was (1) constructed, (2) reconstructed, or (3) plugged under my jurisdiction and was completed on (mo/day/year) 07-06-94 and this record is true to the best of my knowledge and belief. Kansas Water Well Contractor's License No. 479 This Water Well Record was completed on (mo/day/yr) 07-20-94 under the business name of EBBERTS DRILLING by (signature) [Signature]