


MN 6

1 LOCATION OF WATER WELL: County: **JEFFERSON** Fraction: **SW 1/4 NW 1/4 SW 1/4** Section Number: **29** Township Number: **T 7 S** Range Number: **R 19 EW**

Distance and direction from nearest town or city street address of well if located within city?  
**Hwy JUNCT - 4 & 59 SOUTH OF NORTONVILLE KS**

2 WATER WELL OWNER: **COUNTRY INN SERVICE ATT. ROBERT LEFLET**  
 RR#, St. Address, Box #: **RR1 - 186A** City, State, ZIP Code: **NORTONVILLE KS 66400**

3 LOCATE WELL'S LOCATION WITH AN "X" IN SECTION BOX:

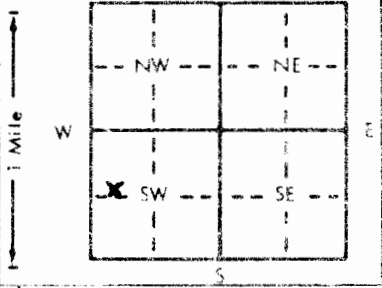

4 DEPTH OF COMPLETED WELL: **15** ft. ELEVATION: **11.5** ft.  
 Depth(s) Groundwater Encountered: 1. **11.5** ft. 2. **-** ft. 3. **-** ft.  
 WELL'S STATIC WATER LEVEL: **16.64** ft. below land surface measured on **07-01-94**  
 Pump test data: Well water was **-** ft. after **-** hours pumping **-** gpm  
 Est. Yield **8.625** gpm. Well water was **15** ft. after **-** hours pumping **-** gpm  
 Bore Hole Diameter: **8.625** in. to **15** ft., and **-** in. to **-** ft.  
 WELL WATER TO BE USED AS:  
 1 Domestic  3 Feedlot  6 Oil field water supply  9 Dewatering  12 Other (Specify below)   
 2 Irrigation  4 Industrial  7 Lawn and garden only  10 Monitoring well

5 TYPE OF BLANK CASING USED:  
 1 Steel  3 RMP (SR)  5 Wrought iron  8 Concrete tile  CASING JOINTS: Glued  Clamped   
 2 PVC  4 ABS  7 Fiberglass  9 Other (specify below)  Welded   
 Blank casing diameter: **2** in. to **5** ft. Dia **SCH 40** in. to **-** ft. Dia **-** in. to **-** ft.  
 Casing height above land surface: **24** in. weight **-** lbs./ft. Wall thickness or gauge No. **-**  
 TYPE OF SCREEN OR PERFORATION MATERIAL:  
 1 Steel  3 Stainless steel  5 Fiberglass  7 PVC  10 Asbestos-cement   
 2 Brass  4 Galvanized steel  6 Concrete tile  8 RMP (SR)  11 Other (specify)   
 12 None used (open hole)

SCREEN OR PERFORATION OPENINGS ARE:  
 1 Continuous slot  3 Mill slot  5 Gauzed wrapped  8 Saw cut  11 None (open hole)   
 2 Louvered shutter  4 Key punched  6 Wire wrapped  9 Drilled holes   
 7 Torch cut  10 Other (specify)

SCREEN-PERFORATED INTERVALS: From **5** ft. to **15** ft. From **-** ft. to **-** ft.  
**SAND** From **4** ft. to **7.5** ft. From **-** ft. to **-** ft.  
 GRAVEL PACK INTERVALS: From **-** ft. to **-** ft. From **-** ft. to **-** ft.

6 GROUT MATERIAL: 1 Neat cement  2 Cement grout  3 Bentonite  4 Other   
 Grout Intervals: From **2** ft. to **2** ft. From **2** ft. to **4** ft. From **-** ft. to **-** ft.

What is the nearest source of possible contamination:  
 1 Septic tank  4 Lateral lines  7 Pit privy  10 Livestock pens  14 Abandoned water well   
 2 Sewer lines  5 Cess pool  8 Sewage lagoon  11 Fuel storage  15 Oil well/Gas well   
 3 Watertight sewer lines  6 Seepage pit  9 Feedyard  12 Fertilizer storage  16 Other (specify below) **CONTAMINATED SITE**  
 13 Insecticide storage

Direction from well? **-** How many feet? **-**

FROM	TO	LITHOLOGIC LOG	FROM	TO	PLUGGING INTERVALS
<b>GL</b>	<b>3</b>	<b>SOIL SILTY CLAY</b>			
<b>3</b>	<b>15</b>				
<b>TD</b>	<b>15</b>				

7 CONTRACTOR'S OR LANDOWNER'S CERTIFICATION: This water well was (1) constructed, (2) reconstructed, or (3) plugged under my jurisdiction and was completed on (mo/day/year) **07-06-94** and this record is true to the best of my knowledge and belief. Kansas Water Well Contractor's License No. **479** This Water Well Record was completed on (mo/day/yr) **07-20-94** under the business name of **EBBERTS DRILLING** by (signature) *Gregory Ebberts*