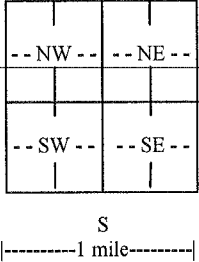


WATER WELL RECORD

Form WWC-5

Division of Water Resources App. No.

1 LOCATION OF WATER WELL: County: <u>Clay</u>	Fraction <u>SW 1/4 NW 1/4 SE 1/4 SW 1/4</u>	Section Number <u>22</u>	Township No. <u>T 7 S</u>	Range Number <u>R 2</u> <input checked="" type="checkbox"/> E <input type="checkbox"/> W
Street/Rural Address of Well Location; if unknown, distance & direction from nearest town or intersection: If at owner's address, check here <input type="checkbox"/> <u>From HWY 15 and 21st Rd, go 4 miles west</u>		Global Positioning System (GPS) information: Latitude: <u>39.4253880</u> (in decimal degrees) Longitude: <u>97.1969050</u> (in decimal degrees) Elevation: Datum: <input type="checkbox"/> WGS 84, <input checked="" type="checkbox"/> NAD 83, <input type="checkbox"/> NAD 27 Collection Method: <input checked="" type="checkbox"/> GPS unit (Make/Model: <u>Handheld</u>) <input type="checkbox"/> Digital Map/Photo, <input type="checkbox"/> Topographic Map, <input type="checkbox"/> Land Survey Est. Accuracy: <input type="checkbox"/> <3 m, <input type="checkbox"/> 3-5 m, <input type="checkbox"/> 5-15 m, <input type="checkbox"/> >15 m		
2 WATER WELL OWNER: <u>Keeott Farms</u> RR#, Street Address, Box #: <u>1047 20th Road</u> City, State, ZIP Code : <u>Clay Center, KS 67432</u>				

3 LOCATE WELL WITH AN "X" IN SECTION BOX: N  S -----1 mile-----	4 DEPTH OF COMPLETED WELL <u>77</u> ft. Depth(s) Groundwater Encountered (1) <u>21</u> ft. (2) ft. (3) ft. WELL'S STATIC WATER LEVEL <u>21</u> ft. below land surface measured on mo/day/yr. <u>05/11/12</u> Pump test data: Well water was <u>58</u> ft. after <u>2</u> hours pumping <u>700</u> gpm EST. YIELD <u>700</u> gpm. Well water was ft. after hours pumping gpm Bore Hole Diameter <u>30</u> in. to <u>77</u> ft., and in. to ft. WELL WATER TO BE USED AS: <input type="checkbox"/> Public water supply <input type="checkbox"/> Geothermal <input type="checkbox"/> Injection well <input type="checkbox"/> Domestic <input type="checkbox"/> Feedlot <input type="checkbox"/> Oil field water supply <input type="checkbox"/> Dewatering <input type="checkbox"/> Other (Specify below) <input checked="" type="checkbox"/> Irrigation <input type="checkbox"/> Industrial <input type="checkbox"/> Domestic-lawn & garden <input type="checkbox"/> Monitoring well Was a chemical/bacteriological sample submitted to Department? <input type="checkbox"/> Yes <input checked="" type="checkbox"/> No If yes, mo/day/yr sample was submitted Water well disinfected? <input type="checkbox"/> Yes <input checked="" type="checkbox"/> No
--	--

5 TYPE OF CASING USED: Steel PVC Other

CASING JOINTS: Glued Clamped Welded Threaded
Casing diameter .16 in. to .57 ft., Diameter in. to ft., Diameter in. to ft.
Casing height above land surface in., Weight lbs./ft., Wall thickness or gauge No. 625

TYPE OF SCREEN OR PERFORATION MATERIAL:
 Steel Stainless Steel PVC Other (Specify)
 Brass Galvanized Steel None used (open hole)

SCREEN OR PERFORATION OPENINGS ARE:
 Continuous slot Mill slot Gauze wrapped Torch cut Drilled holes None (open hole)
 Louvered shutter Key punched Wire wrapped Saw cut Other (specify)

SCREEN-PERFORATED INTERVALS: From 57 ft. to 77 ft., From ft. to ft.
From ft. to ft., From ft. to ft.

GRAVEL PACK INTERVALS: From 20 ft. to 50 ft., From 60 ft. to 77 ft.
From ft. to ft., From ft. to ft.


6 GROUT MATERIAL: Neat cement Cement grout Bentonite Other

Grout Intervals: From 0 ft. to 20 ft., From 50 ft. to 60 ft., From ft. to ft.

What is the nearest source of possible contamination:
 Septic tank Lateral lines Pit privy Livestock pens Insecticide storage Other (specify below)
 Sewer lines Cesspool Sewage lagoon Fuel storage Abandoned water well
 Watertight sewer lines Seepage pit Feedyard Fertilizer storage Oil well/gas well

Direction from well Distance from well

FROM	TO	LITHOLOGIC LOG	FROM	TO	LITHO. LOG (cont.) or PLUGGING INTERVALS
0	10	Topsoil			
10	20	Clay			
20	28	Fine sand			
28	50	Sand			
50	60	Clay			
60	62	Fine sand			
62	75	Sand and gravel			
75	80	Shale			

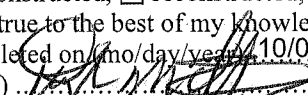7 CONTRACTOR'S OR LANDOWNER'S CERTIFICATION: This water well was constructed, reconstructed, or plugged under my jurisdiction and was completed on (mo/day/year) 05/11/2012 and this record is true to the best of my knowledge and belief. Kansas Water Well Contractor's License No. 755 This Water Well Record was completed on (mo/day/year) 10/03/2012 under the business name of Sargent Drilling by (signature) 

INSTRUCTIONS: Use typewriter or ball point pen. PLEASE PRESS FIRMLY and PRINT clearly. Please fill in blanks and check the correct answers. Send three copies (white, blue, pink) to Kansas Department of Health and Environment, Bureau of Water, Geology Section, 1000 SW Jackson St., Suite 420, Topeka, Kansas 66612-1367. Telephone 785-296-5524. Send one copy to WATER WELL OWNER and retain one for your records. Include fee of \$5.00 for each constructed well. Visit us at <http://www.kdheks.gov/waterwell/index.html>.