

WATER WELL RECORD


Form WWC-5

Division of Water Resources App. No. []

1 LOCATION OF WATER WELL: County: Clay Fraction 1/4 SW 1/4 SW 1/4 SE 1/4 Section Number 27 Township No. T 7 S Range Number R 2 [X]E []W

Street/Rural Address of Well Location; if unknown, distance & direction from nearest town or intersection: If at owner's address, check here []. Global Positioning System (GPS) information: Latitude: 39.4093575 Longitude: 97.1912187

2 WATER WELL OWNER: Susie Young Heirs RR#, Street Address, Box #: 2343 Javhawk Road City, State, ZIP Code : Clay Center, Kansas 67468

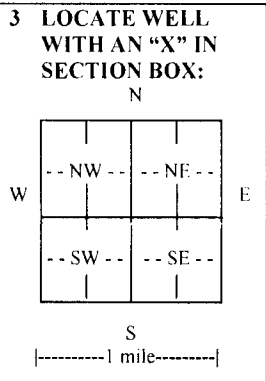

4 DEPTH OF COMPLETED WELL 61' Depth(s) Groundwater Encountered (1) 23' (2) (3) WELL'S STATIC WATER LEVEL 23' below land surface measured on mo/day/yr. Pump test data: Well water was ...ft. after ... hours pumping ... gpm EST. YIELD ... gpm

5 TYPE OF CASING USED: [] Steel [X] PVC [] Other CASING JOINTS: [] Glued [] Clamped [] Welded [X] Threaded Casing diameter .12 in. to .61 ft., Diameter ... in. to ... ft. Casing height above land surface .12 in., Weight ... lbs./ft., Wall thickness or gauge No. SDR26

6 GROUT MATERIAL: [] Neat cement [] Cement grout [X] Bentonite [] Other Grout Intervals: From .20' ft. to .0' ft., From ... ft. to ... ft. What is the nearest source of possible contamination: [] Septic tank [] Lateral lines [] Pit privy [] Livestock pens [] Insecticide storage [X] Other (specify below) none

Table with 6 columns: FROM, TO, LITHOLOGIC LOG, FROM, TO, LITHO. LOG (cont.) or PLUGGING INTERVALS. The table is currently empty.

7 CONTRACTOR'S OR LANDOWNER'S CERTIFICATION: This water well was [] constructed, [X] reconstructed, or [] plugged under my jurisdiction and was completed on (mo/day/year) 07/31/2014 ... and this record is true to the best of my knowledge and belief. Kansas Water Well Contractor's License No. 631. This Water Well Record was completed on (mo/day/year) 08/31/2014 under the business name of Alexander Pump & Services, Inc. by (signature) Larry W. Alexander

INSTRUCTIONS: Use typewriter or ball point pen. PLEASE PRESS FIRMLY and PRINT clearly. Please fill in blanks and check the correct answers. Send one copy to Kansas Department of Health and Environment, Bureau of Water, Geology Section, 1000 SW Jackson St., Suite 420, Topeka, Kansas 66612-1367. Telephone 785-296-5524. Send one copy to WATER WELL OWNER and retain one for your records. Include fee of \$5 00 for each constructed well. Visit us at http://www.kdheks.gov/waterwell/index.html