R 57

WATER WELL RECORD Form WWC-5 KSA 82a-1212

1 LOCATION OF WATER WELL: County: CLAY | Fraction: NW ¼ SW ¼ NW ¼ | Section Number: 11 | Township Number: T 7 S | Range Number: R 2 E E/W

Distance and direction from nearest town or city street address of well if located within city?
1 mile East of Morganville

2 WATER WELL OWNER: Chester Anderson
RR#, St. Address, Box # : Route 1
City, State, ZIP Code : Morganville, Ks. 67468
Board of Agriculture, Division of Water Resources
Application Number: 33,641

3 LOCATE WELL'S LOCATION WITH AN "X" IN SECTION BOX:

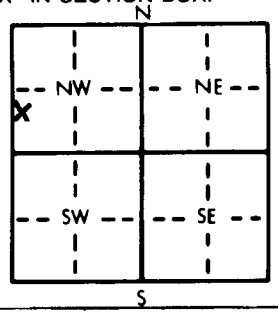

4 DEPTH OF COMPLETED WELL 60' ft. ELEVATION:
Depth(s) Groundwater Encountered 1. 24' ft. 2. ft. 3. ft.
WELL'S STATIC WATER LEVEL 18' ft. below land surface measured on mo/day/yr 12 - 9 - 81
Pump test data: Well water was 55 ft. after 1 hours pumping 800 gpm
Est. Yield 800 gpm: Well water was ft. after hours pumping gpm
Bore Hole Diameter 30" in. to 60' ft., and in. to ft.
WELL WATER TO BE USED AS: 1 Domestic 2 Irrigation X 3 Feedlot 4 Industrial 5 Public water supply 6 Oil field water supply 7 Lawn and garden only 8 Air conditioning 9 Dewatering 10 Observation well 11 Injection well 12 Other (Specify below)
Was a chemical/bacteriological sample submitted to Department? Yes No X; If yes, mo/day/yr sample was submitted
Water Well Disinfected? Yes X No

5 TYPE OF BLANK CASING USED: 1 Steel 2 PVC 3 RMP (SR) 4 ABS 5 Wrought iron X 6 Asbestos-Cement 7 Fiberglass 8 Concrete tile 9 Other (specify below)
CASING JOINTS: Glued Clamped X Welded Threaded
Blank casing diameter 16" in. to 34' ft., Dia in. to ft., Dia in. to ft.
Casing height above land surface 12 in., weight 34# lbs./ft. Wall thickness or gauge No. 3/4

TYPE OF SCREEN OR PERFORATION MATERIAL: 1 Steel 2 Brass 3 Stainless steel 4 Galvanized steel 5 Fiberglass 6 Concrete tile 7 PVC 8 RMP (SR) 9 ABS X 10 Asbestos-cement 11 Other (specify) 12 None used (open hole)
SCREEN OR PERFORATION OPENINGS ARE: 1 Continuous slot 2 Louvered shutter 3 Mill slot 4 Key punched 5 Gauzed wrapped 6 Wire wrapped 7 Torch cut X 8 Saw cut 9 Drilled holes 10 Other (specify) 11 None (open hole)
SCREEN-PERFORATED INTERVALS: From 34' ft. to 60' ft., From ft. to ft.
From ft. to ft., From ft. to ft.
GRAVEL PACK INTERVALS: From 10' ft. to 60' ft., From ft. to ft.
From ft. to ft., From ft. to ft.

6 GROUT MATERIAL: 1 Neat cement X 2 Cement grout 3 Bentonite 4 Other
Grout Intervals: From 0 ft. to 10 ft., From ft. to ft., From ft. to ft.
What is the nearest source of possible contamination: NONE
1 Septic tank 2 Sewer lines 3 Watertight sewer lines 4 Lateral lines 5 Cess pool 6 Seepage pit 7 Pit privy 8 Sewage lagoon 9 Feedyard 10 Livestock pens 11 Fuel storage 12 Fertilizer storage 13 Insecticide storage 14 Abandoned water well 15 Oil well/Gas well 16 Other (specify below)
Direction from well? How many feet?

FROM	TO	LITHOLOGIC LOG	FROM	TO	LITHOLOGIC LOG
0	24'	Top Soil & Clay			
24	28	Sand			
28	32	Sand			
32	33	Clay Lense			
33	36	Sand & Gravel			
36	37	Clay Lense			
37	40	Fair Gravel			
40	48	Good Gravel			
48	50	Clay Lense			
50	55	Sand & Gravel			
55	60	Clay & Shale			
60		Stopped			

7 CONTRACTOR'S OR LANDOWNER'S CERTIFICATION: This water well was (1) constructed, (2) reconstructed, or (3) plugged under my jurisdiction and was completed on (mo/day/year) 12 - 9 - 1981 and this record is true to the best of my knowledge and belief. Kansas Water Well Contractor's License No. 361 This Water Well Record was completed on (mo/day/yr) 12 - 10 - 1981
under the business name of Cox-Beswick Irrigation Service, Inc. by (signature) Francis Cox

INSTRUCTIONS: Use typewriter or ball point pen, *PLEASE PRESS FIRMLY* and *PRINT* clearly. Please fill in blanks, underline or circle the correct answers. Send top three copies to Kansas Department of Health and Environment, Division of Environment, Environmental Geology Section, Topeka, KS 66620. Send one to WATER WELL OWNER and retain one for your records.

OFFICE USE ONLY T 7 R 2 E SEC. 11 NW¼ SW¼ NW¼