R94

USE TYPEWRITER OR BALL POINT PEN-PRESS FIRMLY, PRINT CLEARLY.

WATER WELL RECORD
KSA 82a-1201-1215

Kansas Department of Health and Environment-Division of Environment
(Water well Contractors)
Topeka, Kansas 66620

1. Location of well:	County	Fraction	Section number	Township number	Range number
	CLAY	SE 1/4 NW 1/4 NE 1/4	28	T 7 S	R 2 (E) W

2. Distance and direction from nearest town or city: 3S ½W
Street address of well location if in city: of MORGANVILLE

3. Owner of well: ERVIN TADDIKEN
R.R. or street: #1
City, state, zip code: CLAY CENTER, KANSAS 67432

4. Locate with "X" in section below:

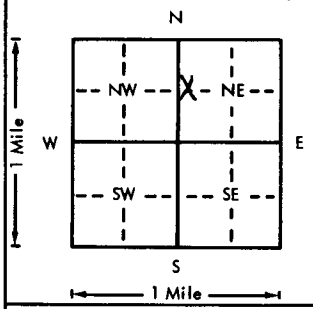

Sketch map:

6. Bore hole dia. 30 in. Completion date 10-30-75
Well depth 53 ft.

7. __ Cable tool __ Rotary __ Driven __ Dug
__ Hollow rod __ Jetted __ Bored X Reverse rotary

8. Use: __ Domestic __ Public supply __ Industry
X Irrigation __ Air conditioning __ Stock
__ Lawn __ Oil field water __ Other

9. Casing: Material AC
Threaded ___ Welded ___
RMP ___ PVC ___
Dia. 14 in. to 53 ft. depth
Dia. ___ in. to ___ ft. depth
Height: (Above) ~~or below~~
Surface 12 in.
Weight 34 lbs./ft.
Wall Thickness: inches or ~~gage No.~~ 3/4"

5. Type and color of material	From	To
Top soil	0	7
SAND	7	28
GRAVEL	28	54
SHALE	54	

(Use a second sheet if needed)

10. Screen: Manufacturer's name JOHNSON
CONCRETE
Type ___ Dia. ___
Slot ~~/gauze~~ 1/8" Length 26
Set between 27 ft. and 53 ft.
___ ft. and ___ ft.
Gravel pack? YES Size range of material 1/8" - 1/4"

11. Static water level: mo./day/yr.
10 ft. below land surface Date 10-30-75

12. Pumping level below land surfaces:
30 ft. after ½ hrs. pumping 1250 g.p.m.
___ ft. after ___ hrs. pumping ___ g.p.m.
Estimated maximum yield ___ g.p.m.

13. Water sample submitted: mo./day/yr.
__ Yes X No Date ___

14. Well head completion:
__ Pitless adapter 12 Inches above grade

15. Well grouted? ___
With: __ Neat cement __ Bentonite ✓ Concrete
Depth: From 0 ft. to 10 ft.

16. Nearest source of possible contamination: RIVER
ft. 1400 Direction W Type ___
Well disinfected upon completion? ___ Yes X No

17. Pump: ___ Not installed
Manufacturer's name WESTERN LAND ROLLER
Model number 8N HP 100 Volts ___
Length of drop pipe 45 ft. capacity 1000 g.p.m.
Type: ENGINE POWERED
__ Submersible X Turbine
__ Jet __ Reciprocating
__ Centrifugal __ Other

T 7 R 2 (E) W Sec 28 SE NW NE 1/4 1/4

18. Elevation:
Topography:
__ Hill
__ Slope
__ Upland
X Valley

19. Remarks:

20. Water well contractor's certification:
This well was drilled under my jurisdiction and this report is true to the best of my knowledge and belief.
GEO COX & SONS, INC 254
Business name License No.
Address CLIFTON, KANSAS
Signed Francis Cox Date 11-26-75
Authorized representative

Forward the white, blue and pink copies to the Department of Health and Environment

Form WWC-5

MI-1023