

USE TYPEWRITER OR BALL POINT PEN-PRESS FIRMLY, PRINT CLEARLY.

T R EW sec 1/4 1/4 1/4 No.

WATER WELL RECORD
KSA 82a-1201-1215


Kansas State Dept. Of Health
(Water Well Contractors)
Forbes-Bldg. 740
Topeka, Kansas 66620

SW 1/4, SE 1/4

1 Location of well:	County CLAY	Township name BLOOM	Fraction SE 1/4	Section number 30	Town number T 7 S	Range number R 2 E
---------------------	-----------------------	-------------------------------	---------------------------	-----------------------------	-----------------------------	------------------------------

Distance and direction from nearest town or city: **6-W, 2-N OF CLAY CENTER**

3 Owner of well: **PAUL PRIZENMAIER**
Address: **CLAY CENTER, KANSAS**

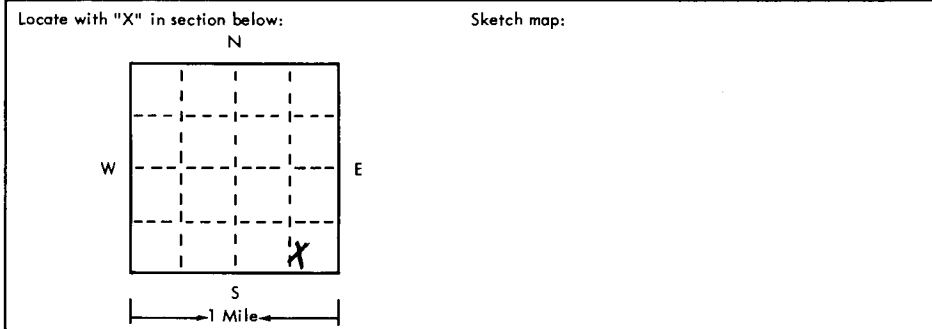

4 Well depth: **72** ft. Date of completion **8/26/75**
Well diameter: **8** in. **BORESIZE**

5 Cable tool Rotary Driven Dug
 Hollow rod Jetted Bored Reverse rotary

6 Use: Domestic Public supply Industry
 Irrigation Air conditioning Commercial
 Test well

7 Casing: Material **PVC** Height **above** below
Threaded Welded Surface **12** in.
Diam. **5** in. Weight **3** lbs./ft.
5 in. to **72** ft. depth Drive shoe? Yes No

2	Type and color of material	From	To
	TOPSOIL BLACK	0	7
	GRAY CLAY	7	32
	ROCK	32	34
	GREEN CLAY	34	68
	GRAVEL	68	70
	GRAY CLAY	70	74
	STOP	74	

8 Screen: Manufacturer **JESS + LAWELL**
Type **PVC** Dia. **5"**
Slot/gauge **1/16"** Length **20**
Set between **72** ft. and **52** ft.
Fittings: Gravel pack Yes No Size range of material **1/4" - 1/2"**

9 Static water level: **50** ft. below land surface Date **8/26/75**

10 Pumping level below land surfaces:
14 ft. after **1/2** hrs. pumping **1/2** g.p.m.
14 ft. after **1/2** hrs. pumping **1/2** g.p.m.
Estimated maximum yield **15** g.p.m.

11 Water sample submitted:
 Yes No Date _____

12 Well head completion:
 Pitless adapter Inches above grade

13 Well grouted? Yes No
 Neat cement Bentonite
Depth: From **3** ft. to **13** ft.

14 Nearest source of possible contamination:
ft. **200** Direction **S W** Type **CREEK**
Well disinfected upon completion? Yes No

15 Pump: Not installed
Manufacturer's name _____ HP _____ Volts _____
Length of drop pipe _____ ft. capacity _____ g.m.p.
Type:
 Submersible Turbine
 Jet Reciprocating
 Centrifugal Other

16 Remarks: elevation

Topography:
 Hill
 Slope
 Upland
 Valley

(use a second sheet if needed)

17 Water well contractor's certification:
This well was drilled under my jurisdiction and this report is true to the best of my knowledge and belief.
Geo Cox + Sons Inc 258
Business name License No. _____
Address **CLAYTON KANSAS**
Signed **Daryl Cox** Date **8/26/75**
Authorized representative