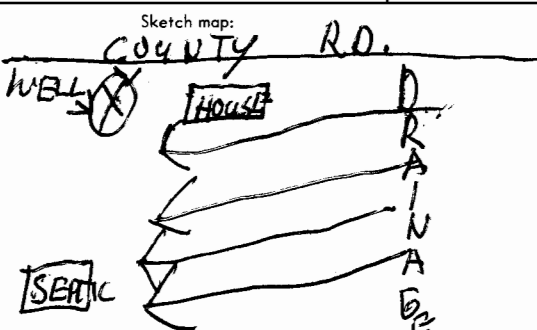


USE TYPEWRITER OR BALL  
POINT PEN-PRESS FIRMLY,  
PRINT CLEARLY.

WATER WELL RECORD  
KSA 82a-1201-1215

Kansas Department of Health and  
Environment-Division of Environment  
(Water well Contractors)  
Topeka, Kansas 66620

1. Location of well:		County <b>Jefferson</b>	Fraction <b>NE 1/4 NE 1/4 NE 1/4</b>	Section number <b>33</b>	Township number <b>T 7</b>	Range number <b>R 20</b>
2. Distance and direction from nearest town or city: <b>4 mi. southwest of Potter, Kansas</b>				3. Owner of well: <b>Randy Lollar</b> R.R. or street: <b>RR #3 Atchison, Kansas 66002</b> City, state, zip code:		
4. Locate with "X" in section below:		Sketch map: 				
5. Type and color of material		From	To	6. Bore hole dia. <b>42</b> in. Completion date <b>9-8-83</b> Well depth <b>48</b> ft. Bore hole <b>50</b> ft. to 11		
Black top soil		0	2	7. Cable tool <input type="checkbox"/> Rotary <input checked="" type="checkbox"/> Driven <input type="checkbox"/> Dug <input type="checkbox"/> Hollow rod <input type="checkbox"/> Jetted <input checked="" type="checkbox"/> Bored <input type="checkbox"/> Reverse rotary		
Very hard yellow clay		2	13	8. Use: <input checked="" type="checkbox"/> Domestic <input type="checkbox"/> Public supply <input type="checkbox"/> Industry <input type="checkbox"/> Irrigation <input type="checkbox"/> Air conditioning <input type="checkbox"/> Stock <input type="checkbox"/> Lawn <input type="checkbox"/> Oil field water <input type="checkbox"/> Other		
Hard yellow clay - gets sandy near 28 ft.		13	28	9. Casing: Material <b>Concrete</b> Above or below Threaded <input type="checkbox"/> Welded <input type="checkbox"/> Surface <b>30</b> in. RMP <input type="checkbox"/> PVC <input type="checkbox"/> Weight <b>320</b> lbs./ft. Dia. <b>36</b> in. to <b>48</b> ft. depth Wall Thickness: inches or Dia. <input type="checkbox"/> in. to <input type="checkbox"/> ft. depth gage No. <b>3 in.</b>		
Water bearing yellow sand and gravel - mixed with clay		28	37	10. Screen: Manufacturer's name _____ Type _____ Dia. _____ Slot/gauze _____ Length _____ Set between _____ ft. and _____ ft. _____ ft. and _____ ft. Gravel pack? _____ Size range of material _____		
Very hard yellow clay		37	48	11. Static water level: _____ mo./day/yr. <b>21</b> ft. below land surface Date <b>9-7-83</b>		
				12. Pumping level below land surfaces: _____ ft. after _____ hrs. pumping _____ g.p.m. <b>28</b> ft. after <b>2</b> hrs. pumping <b>6</b> g.p.m. Estimated maximum yield <b>4</b> g.p.m.		
				13. Water sample submitted: _____ mo./day/yr. <input type="checkbox"/> Yes <input checked="" type="checkbox"/> No Date _____		
				14. Well head completion: <input type="checkbox"/> Pitless adapter _____ Inches above grade		
				15. Well grouted? <input checked="" type="checkbox"/> With: <input checked="" type="checkbox"/> Neat cement <input type="checkbox"/> Bentonite <input type="checkbox"/> Concrete Depth: From <b>0</b> ft. to <b>11</b> ft.		
				16. Nearest source of possible contamination: ft. <b>400</b> Direction <b>Southwest Septic</b> Well disinfected upon completion? <input checked="" type="checkbox"/> Yes <input type="checkbox"/> No		
				17. Pump: <input checked="" type="checkbox"/> Not installed Manufacturer's name _____ Model number _____ HP _____ Volts _____ Length of drop pipe _____ ft. capacity _____ g.p.m. Type: <input type="checkbox"/> Submersible <input type="checkbox"/> Turbine <input type="checkbox"/> Jet <input type="checkbox"/> Reciprocating <input type="checkbox"/> Centrifugal <input type="checkbox"/> Other		
18. Elevation:		19. Remarks:		20. Water well contractor's certification: This well was drilled under my jurisdiction and this report is true to the best of my knowledge and belief. <b>Popplewell Well Boring 320</b> Business name _____ License No. _____ Address <b>Amity, Mo. 64422</b> Signed <b>Jerry Popplewell</b> Date <b>9-23-83</b> Authorized representative		