


1	LOCATION OF WATER WELL:	Fraction	Section Number	Township Number	Range Number
County:	CLAY	SE 1/4 NE 1/4 NE 1/4	31	T-7-S	R-3-E E/W

Distance and direction from nearest town or city street address of well if located within city?
 3/4 MILES NORTH OF CLAY CENTER KS.

2	WATER WELL OWNER: CRAIG REGNIER 1744 BERGLUND DR. RR #, St. Address, Box #: City, State, ZIP Code : CLAY CENTER KS. 67432	Board of Agriculture, Division of Water Resources Application Number:
---	--	--

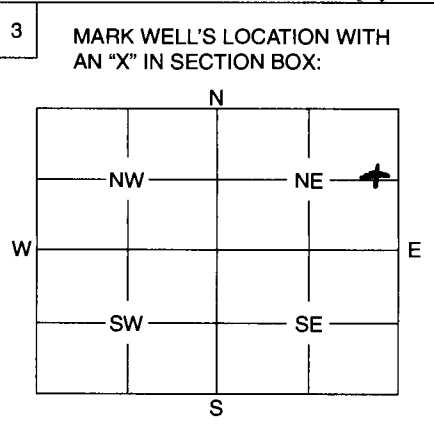

4	DEPTH OF WELL 63 ft. WELL'S STATIC WATER LEVEL 33 ft. WELL WAS USED AS: 1 Domestic (circled) 2 Irrigation 3 Feedlot 4 Industrial 5 Public Water Supply 6 Oil Field Water Supply 7 Domestic (Lawn & Garden) 8 Air Conditioning 9 Dewatering 10 Monitoring Well 11 Injection Well 12 Other Was a chemical / bacteriological sample submitted to Department? Yes No <input checked="" type="checkbox"/> If yes, mo/day/yr sample was submitted Water Well Disinfected: Yes <input checked="" type="checkbox"/> No
---	---

5	TYPE OF BLANK CASING USED: 1 Steel 2 PVC (circled) 3 RMP (SR) 4 ABS 5 Wrought 6 Asbestos-Cement 7 Fiberglass 8 Concrete Tile 9 Other (Specify below) Blank casing diameter 5 in. Casing height above below land surface 5 FT Was casing pulled? Yes No <input checked="" type="checkbox"/> If yes, how much
---	--

6	GROUT PLUG MATERIAL: 1 Neat cement 2 Cement grout 3 Bentonite (circled) 4 Other Grout Plug Intervals: From 63 ft. to 58 ft., From ft. to ft., From to ft. What is the nearest source of possible contamination: 1 Septic tank 2 Sewer lines 3 Watertight sewer lines (circled) 4 Lateral lines 5 Cess pool 6 Seepage pit 7 Pit privy 8 Sewage lagoon 9 Feedyard 10 Livestock pens 11 Fuel storage 12 Fertilizer storage 13 Insecticide storage 14 Abandoned water well 15 Oil well/Gas well 16 Other (specify below) Direction from well? NORTH How many feet? 20
---	--

FROM	TO	PLUGGING MATERIALS
63	5	BENTONITE (8.12 CU. FT.)
5	0	SILT & CLAY

7	CONTRACTOR'S OF LANDOWNER'S CERTIFICATION: This water well was plugged under my jurisdiction and was completed on (mo/day/year) 7-10-03 and this record is true to the best of my knowledge and belief. Kansas Water Well Contractor's License No. 647 This Water Well Record was completed on (mo/day/year) 7-23-03 under the business name of MEL'S PUMP & PLUMBING by (signature) Melvin M Anderson
---	---

INSTRUCTIONS: Use typewriter or ball point pen. Please press firmly and print clearly. Please fill in blanks, underline or circle the correct answers. Send top three copies to Kansas Department of Health and Environment, Bureau of Water, Geology Section, 1000 SW Jackson St., Ste. 420, Topeka, Kansas 66612-1367. Telephone: 785/296-5522. Send one to Water Well Owner and retain one for your records.