


1 LOCATION OF WATER WELL: Fraction NW 1/4 SW 1/4 NW 1/4 Section Number 29 Township Number T-7-S Range Number R-3-E
 County: CLAY

Distance and direction from nearest town or city street address of well if located within city?

2 WATER WELL OWNER: GARY HABLWETZEL
2056 NAVAJO RD
 RR #, St. Address, Box #: _____ Board of Agriculture, Division of Water Resources
 City, State, ZIP Code: CLAY CENTER KS 67432 Application Number: _____

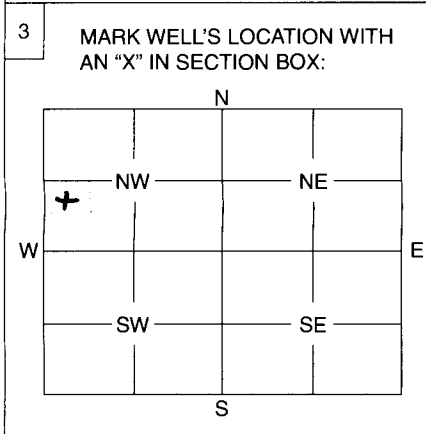

4 DEPTH OF WELL 30 ft.
 WELL'S STATIC WATER LEVEL 14 ft.
 WELL WAS USED AS:
 1 Domestic 5 Public Water Supply 9 Dewatering
 2 Irrigation 6 Oil Field Water Supply 10 Monitoring Well
 3 Feedlot 7 Domestic (Lawn & Garden) 11 Injection Well
 4 Industrial 8 Air Conditioning 12 Other _____
 Was a chemical / bacteriological sample submitted to Department? Yes _____ No
 If yes, mo/day/yr sample was submitted _____
 Water Well Disinfected: Yes No _____

5 TYPE OF BLANK CASING USED:
 1 Steel 3 RMP (SR) 5 Wrought 7 Fiberglass 9 Other (Specify below)
 2 PVC 4 ABS 6 Asbestos-Cement 8 Concrete Tile
 Blank casing diameter 5 in. Was casing pulled? Yes No _____ If yes, how much 4 FT
~~Casing height above or below land surface~~ 48 in.

6 GROUT PLUG MATERIAL: 1 Neat cement 2 Cement grout 3 Bentonite 4 Other _____
 Grout Plug Intervals: From 14 ft. to 4 ft., From _____ ft. to _____ ft., From _____ to _____ ft.
 What is the nearest source of possible contamination:
 1 Septic tank 6 Seepage pit 11 Fuel storage 16 Other (specify below)
 2 Sewer lines 7 Pit privy 12 Fertilizer storage
 3 Watertight sewer lines 8 Sewage lagoon 13 Insecticide storage
 4 Lateral lines 9 Feedyard 14 Abandoned water well
 5 Cess pool 10 Livestock pens 15 Oil well/Gas well
 Direction from well? SOUTH How many feet? 140

FROM	TO	PLUGGING MATERIALS
30	14	Washed gravel
14	4	Bentonite
4	0	top soil

7 CONTRACTOR'S OF LANDOWNER'S CERTIFICATION: This water well was plugged under my jurisdiction and was completed on (mo/day/year) MARCH 18 2011 and this record is true to the best of my knowledge and belief. Kansas Water Well Contractor's License No. 6047 This Water Well Record was completed on (mo/day/year) MAR 20 - 2011 under the business name of MEL'S PUMP & PLUMBING INC
 by (signature) Melvin M Anderson

INSTRUCTIONS: Use typewriter or ball point pen. Please press firmly and print clearly. Please fill in blanks, underline or circle the correct answers. Send top three copies to Kansas Department of Health and Environment, Bureau of Water, Geology Section, 1000 SW Jackson St., Ste. 420, Topeka, Kansas 66612-1367. Telephone: 785/296-5522. Send one to Water Well Owner and retain one for your records.