R 106

USE TYPEWRITER OR BALL POINT PEN-PRESS FIRMLY, PRINT CLEARLY.

WATER WELL RECORD
KSA 82a-1201-1215

Kansas Department of Health and Environment-Division of Environment
(Water well Contractors)
Topeko, Kansas 66620

1. Location of well: County: Clay | Fraction: SW 1/4 NE 1/4 NE 1/4 | Section number: 14 | Township number: T 7 S | Range number: R 3 E E/W

2. Distance and direction from nearest town or city: green 3 north 4 West
Street address of well location if in city: 4 3/4 north west side road

3. Owner of well: Warren Walquist
R.R. or street:
City, state, zip code: Green Kans

4. Locate with "X" in section below:

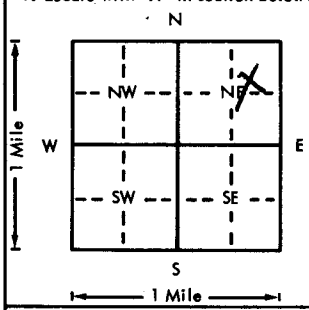

Sketch map:

6. Bore hole dia. 10 in. Completion date 7-26-76
Well depth 119 ft.

7. X Cable tool __ Rotary __ Driven __ Dug
__ Hollow rod __ Jetted __ Bored __ Reverse rotary

8. Use: X Domestic __ Public supply __ Industry
__ Irrigation __ Air conditioning __ Stock
__ Lawn __ Oil field water __ Other

9. Casing: Material _____ Height: Above or below
Threaded ____ Welded ____ Surface 14 in.
RMP ____ PVC X Weight ____ lbs./ft.
Dia. 5 in. to 120 ft. depth Wall Thickness: inches Wall
Dia. ____ in. to ____ ft. depth gage No. Sch 40

10. Screen: Manufacturer's name Pumpco M-Pl
Type PVC Dia. 5"
Slot/gauze .040 Length 40
Set between 101 ft. and 60 ft.
99 ft. and 119 ft.
Gravel pack? X Size range of material 1/8 X 1/4

11. Static water level: mo./day/yr.
36 ft. below land surface Date 7-26-76

12. Pumping level below land surfaces:
____ ft. after ____ hrs. pumping ____ g.p.m.
____ ft. after ____ hrs. pumping ____ g.p.m.
Estimated maximum yield 3 g.p.m.

13. Water sample submitted: mo./day/yr.
__ Yes X No Date

14. Well head completion: NA
__ Pitless adapter ____ Inches above grade

15. Well grouted? X 1-2
With: __ Neat cement __ Bentonite X Concrete
Depth: From 4 ft. to 15 ft.

16. Nearest source of possible contamination:
ft. 150 Direction EAST Type Septic tank
Well disinfected upon completion? X Yes __ No

17. Pump: X Not installed
Manufacturer's name
Model number ____ HP ____ Volts ____
Length of drop pipe ____ ft. capacity ____ g.p.m.
Type:
__ Submersible __ Turbine
__ Jet __ Reciprocating
__ Centrifugal __ Other

5. Type and color of material

From	To
0	5
5	10
10	22
22	50
50	56
56	75
75	81
81	119

tof soil, Black
Clay, Red
Rock Yellow lime
Shale Blue
" Red
" Blue
" Red
Shale Rock Blue Hard

(Use a second sheet if needed)

18. Elevation:

Topography:
__ Hill
X Slope
__ Upland
__ Valley

19. Remarks:

20. Water well contractor's certification:
This well was drilled under my jurisdiction and this report is true to the best of my knowledge and belief.
Business name Strader Drilling Co. License No. 23
Address Blue Rapids
Signed Harold Strader Date 7-26-76
Authorized representative

Forward the white, blue and pink copies to the Department of Health and Environment

Form WWC-5

M1-1023

T 7 S R 3 W Sec 14 SW 1/4 NE 1/4 NE 1/4