


1 LOCATION OF WATER WELL: County: <u>Clay</u>	Fraction <u>NE 1/4 NE 1/4 NE 1/4</u>	Section Number <u>27</u>	Township Number <u>T 7 S</u>	Range Number <u>R 3</u>
--	---	-----------------------------	---------------------------------	----------------------------

Distance and direction from nearest town or city street address of well if located within city?
3 miles North and 2 miles East of Clay Center

2 WATER WELL OWNER: Aileen Allen
RR#, St. Address, Box # : 7090 E. Mescal #40
City, State, ZIP Code : Scottsdale AZ 85254
Board of Agriculture, Division of Water Resources
Application Number:

3 LOCATE WELL'S LOCATION WITH AN "X" IN SECTION BOX: 4 DEPTH OF COMPLETED WELL: 37 ft. ELEVATION:

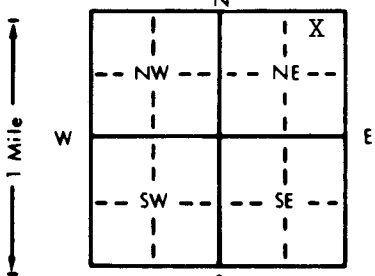

Depth(s) Groundwater Encountered 1. _____ ft. 2. _____ ft. 3. _____ ft.
WELL'S STATIC WATER LEVEL 17 ft. below land surface measured on mo/day/yr 1/26/95
Pump test data: Well water was _____ ft. after _____ hours pumping _____ gpm
Est. Yield _____ gpm: Well water was _____ ft. after _____ hours pumping _____ gpm
Bore Hole Diameter _____ in. to _____ ft., and _____ in. to _____ ft.
WELL WATER TO BE USED AS:
 Domestic 3 Feedlot 6 Oil field water supply 9 Dewatering 12 Other (Specify below)
 2 Irrigation 4 Industrial 7 Lawn and garden only 10 Monitoring well
Was a chemical/bacteriological sample submitted to Department? Yes _____ No X; If yes, mo/day/yr sample was submitted _____
Water Well Disinfected? Yes No

5 TYPE OF BLANK CASING USED:
 Steel 3 RMP (SR) 6 Asbestos-Cement 9 Other (specify below)
 2 PVC 4 ABS 7 Fiberglass
Blank casing diameter 4.0 in. to _____ ft., Dia _____ in. to _____ ft.
Casing height above land surface 60 in., weight _____ lbs./ft. Wall thickness or gauge No. _____

TYPE OF SCREEN OR PERFORATION MATERIAL:
1 Steel 3 Stainless steel 5 Fiberglass 8 RMP (SR)
2 Brass 4 Galvanized steel 6 Concrete tile 9 ABS 12 None used (open hole)
7 PVC 10 Asbestos-cement NA
11 Other (specify) _____

SCREEN OR PERFORATION OPENINGS ARE:
1 Continuous slot 3 Mill slot 6 Wire wrapped 9 Drilled holes 12 None (open hole)
2 Louvered shutter 4 Key punched 7 Torch cut 10 Other (specify) NA

SCREEN-PERFORATED INTERVALS: From NA ft. to NA ft., From _____ ft. to _____ ft.
GRAVEL PACK INTERVALS: From _____ ft. to _____ ft., From _____ ft. to _____ ft.

6 GROUT MATERIAL: 1 Neat cement 2 Cement grout 3 Bentonite 4 Other _____
Grout Intervals: From 8 ft. to 5 ft., From _____ ft. to _____ ft., From _____ ft. to _____ ft.

What is the nearest source of possible contamination:
 Septic tank 4 Lateral lines 7 Pit privy 10 Livestock pens 14 Abandoned water well
 2 Sewer lines 5 Cess pool 8 Sewage lagoon 11 Fuel storage 15 Oil well/Gas well
 3 Watertight sewer lines 6 Seepage pit 9 Feedyard 12 Fertilizer storage 16 Other (specify below)
 13 Insecticide storage _____
Direction from well? West How many feet? 1,300

FROM	TO	LITHOLOGIC LOG	FROM	TO	PLUGGING INTERVALS
			<u>37</u>	<u>8</u>	<u>Sand</u>
			<u>8</u>	<u>5</u>	<u>Bentonite</u>
			<u>5</u>	<u>0</u>	<u>Topsoil</u>

7 CONTRACTOR'S OR LANDOWNER'S CERTIFICATION: This water well was (1) constructed, (2) reconstructed, or (3) plugged under my jurisdiction and was completed on (mo/day/year) 4-17-95 and this record is true to the best of my knowledge and belief. Kansas Water Well Contractor's License No. _____ This Water Well Record was completed on (mo/day/yr) 4-17-95 under the business name of Bensen Farms by (signature) [Signature]