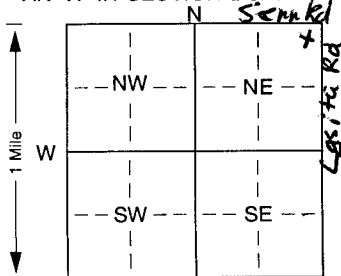


1] LOCATION OF WATER WELL: Fraction NE 1/4 NE 1/4 NE 1/4 Section Number 35 Township Number T 7 S Range Number R 4 E
 County: Riley
 Distance and direction from nearest town or city street address of well if located within city? 4 1/2 miles west of Leonardsville, K on Hwy 24 then 3 miles north on Lasita Rd. & County Rd - 873 - west side of road

2] WATER WELL OWNER: Bobby Lee Brenner
 RR#, St. Address, Box #: 13121 Lasita Rd
 City, State, ZIP Code: Green, Ks. 67447
 Board of Agriculture, Division of Water Resources
 Application Number:

3] LOCATE WELL'S LOCATION WITH AN "X" IN SECTION BOX:

 4] DEPTH OF COMPLETED WELL: 212 ft. ELEVATION:
 Depth(s) Groundwater Encountered 1, 180 ft. 2. ft. 3. ft.
 WELL'S STATIC WATER LEVEL 170 ft. below land surface measured on mo/day/yr
 Pump test data: Well water was ft. after hours pumping gpm
 Est. Yield 157 gpm; Well water was ft. after hours pumping gpm
 Bore Hole Diameter: 9 in. to ft., and in. to ft.
 WELL WATER TO BE USED AS: 5 Public water supply 8 Air conditioning 11 Injection well
 1 Domestic 3 Feedlot 6 Oil field water supply 9 Dewatering 12 Other (Specify below)
 2 Irrigation 4 Industrial 7 Domestic (lawn & garden) 10 Monitoring well
 Was a chemical/bacteriological sample submitted to Department? Yes. No. ; If yes, mo/day/yr sample was submitted
 Water Well Disinfected? Yes No

5] TYPE OF BLANK CASING USED: 5 Wrought iron 8 Concrete tile CASING JOINTS: Glued Clamped.
 1 Steel 3 RMP (SR) 6 Asbestos-Cement 9 Other (specify below) Welded
 2 PVD 4 ABS 7 Fiberglass Threaded.
 Blank casing diameter 5 in. to 182 ft., Dia in. to ft., Dia in. to ft.
 Casing height above land surface: 2 in., weight sch 40 lbs./ft. Wall thickness or gauge No.
 TYPE OF SCREEN OR PERFORATION MATERIAL: 7 PVD 10 Asbestos-cement
 1 Steel 3 Stainless steel 5 Fiberglass 8 RMP (SR) 11 Other (specify)
 2 Brass 4 Galvanized steel 6 Concrete tile 9 ABS 12 None used (open hole)
 SCREEN OR PERFORATION OPENINGS ARE: 5 Gauzed wrapped 8 Saw cut 11 None (open hole)
 1 Continuous slot 3 Mill slot 25/1100 6 Wire wrapped 9 Drilled holes
 2 Louvered shutter 4 Key punched 7 Torch cut 10 Other (specify) ft.
 SCREEN-PERFORATED INTERVALS: From 182 ft. to 212 ft., From ft. to ft.
 GRAVEL PACK INTERVALS: From 25 ft. to 212 ft., From ft. to ft.
 From ft. to ft., From ft. to ft.

6] GROUT MATERIAL: 1 Neat cement 2 Cement grout 3 Bentonite 4 Other
 Grout Intervals: From 0 ft. to 25 ft., From ft. to ft., From ft. to ft.
 What is the nearest source of possible contamination:
 1 Septic tank 4 Lateral lines 7 Pit privy 11 Fuel storage 14 Abandoned water well
 2 Sewer lines 5 Cess pool 8 Sewage lagoon 12 Fertilizer storage 15 Oil well/Gas well
 3 Watertight sewer lines 6 Seepage pit 9 Feedyard 13 Insecticide storage 16 Other (specify below)
 Direction from well? West How many feet? 75'
Septic System

FROM	TO	LITHOLOGIC LOG	FROM	TO	PLUGGING INTERVALS
0	1/4	Top Soil	170	190	Limestone
1/2	1 1/2	Limestone	190	205	Gray Shale
1 1/2	16	Brown Shale	205	212	Limestone
16	43	Yellow Shale			
43	46	Limestone			
46	56	Greenish Shale			
56	71	Limestone			
71	77	Greenish Shale			
77	82	Limestone			
82	106	Brown Shale			
106	121	Limestone			
121	135	Brown Shale			
135	144	Limestone			
144	170	Brown Shale			

7] CONTRACTOR'S OR LANDOWNER'S CERTIFICATION: This water well was (1) constructed, (2) reconstructed, or (3) plugged under my jurisdiction and was completed on (mo/day/year) 2/29/2001 and this record is true to the best of my knowledge and belief, Kansas Water Well Contractor's Licence No. 451 This Water Well Record was completed on (mo/day/yr) 3/29/2001 under the business name of Holdman Well Drilling by (signature) Craig C. P. I.