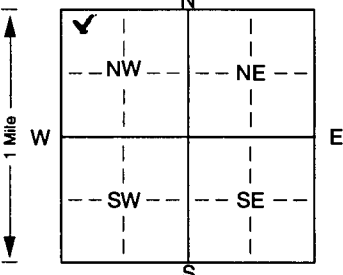


1 LOCATION OF WATER WELL: Fraction NW 1/4 NW 1/4 NW 1/4 Section Number 21 Township Number T 7 S Range Number R 4 E
 County: Clay
 Distance and direction from nearest town or city street address of well if located within city? From Green north 1/2 mile + 1 mile west on 22nd Rd on south side Address 2006 22nd Road

2 WATER WELL OWNER: Mildred Pfeifley
 RR#, St. Address, Box #: 1323 Dexter Board of Agriculture, Division of Water Resources
 City, State, ZIP Code: Clay Center, Ks 67432 Application Number:

3 LOCATE WELL'S LOCATION WITH AN "X" IN SECTION BOX:

 4 DEPTH OF COMPLETED WELL: 120.89 ft. ELEVATION:
 Depth(s) Groundwater Encountered: 1 8.9 ft. 2. ft. 3. ft.
 WELL'S STATIC WATER LEVEL: 20 ft. below land surface measured on mo/day/yr
 Pump test data: Well water was ft. after hours pumping gpm
 Est. Yield: 15 gpm: Well water was ft. after hours pumping gpm
 Bore Hole Diameter: 9 in. to 10 ft., and in. to ft.
 WELL WATER TO BE USED AS: 5 Public water supply 8 Air conditioning 11 Injection well
Domestic 3 Feedlot 6 Oil field water supply 9 Dewatering 12 Other (Specify below)
 2 Irrigation 4 Industrial 7 Domestic (lawn & garden) 10 Monitoring well
 Was a chemical/bacteriological sample submitted to Department? Yes. No. ; If yes, mo/day/yr sample was submitted
 Water Well Disinfected? Yes No

5 TYPE OF BLANK CASING USED: 5 Wrought iron 8 Concrete tile CASING JOINTS: glued Clamped.
 1 Steel 3 RMP (SR) 6 Asbestos-Cement 9 Other (specify below) Welded
2 PVC 4 ABS 7 Fiberglass Threaded.
 Blank casing diameter: 5 in. to 100 ft., Dia in. to ft., Dia in. to ft.
 Casing height above land surface: 2' in., weight Sch. 40 lbs./ft. Wall thickness or gauge No.
 TYPE OF SCREEN OR PERFORATION MATERIAL: PVC 10 Asbestos-cement
 1 Steel 3 Stainless steel 5 Fiberglass 8 RMP (SR) 11 Other (specify)
 2 Brass 4 Galvanized steel 6 Concrete tile 9 ABS 12 None used (open hole)
 SCREEN OR PERFORATION OPENINGS ARE: 5 Gauzed wrapped 8 Saw cut 11 None (open hole)
 1 Continuous slot 3 Mill slot 25 6 Wire wrapped 9 Drilled holes
 2 Louvered shutter 4 Key punched 1000 7 Torch cut 10 Other (specify) ft.
 SCREEN-PERFORATED INTERVALS: From: 100 ft. to 120 ft., From ft. to ft.
 From: ft. to ft., From ft. to ft.
 GRAVEL PACK INTERVALS: From: 25 ft. to 120 ft., From ft. to ft.
 From: ft. to ft., From ft. to ft.

6 GROUT MATERIAL: 1 Neat cement 2 Cement grout 3 Bentonite 4 Other
 Grout Intervals: From: 0 ft. to 25 ft., From ft. to ft., From ft. to ft.
 What is the nearest source of possible contamination:
 1 Septic tank 4 Lateral lines 7 Pit privy 10 Livestock pens 14 Abandoned water well
 2 Sewer lines 5 Cess pool 8 Sewage lagoon 11 Fuel storage 15 Oil well/Gas well
 3 Watertight sewer lines 6 Seepage pit 9 Feedyard 12 Fertilizer storage 16 Other (specify below)
 13 Insecticide storage
 Direction from well? North west How many feet? 150

FROM	TO	LITHOLOGIC LOG	FROM	TO	PLUGGING INTERVALS
0	1	Top Soil			
1	3	brown clay			
3	21	yellow shale			
21	25	Limestone			
25	56	yellow shale			
56	61	Limestone			
61	72	brown shale			
72	76	Limestone			
76	89	brown shale			
89	100	Limestone (water)			
100	109	gray shale			
109	120	Limestone			

7 CONTRACTOR'S OR LANDOWNER'S CERTIFICATION: This water well was (1) constructed, (2) reconstructed, or (3) plugged under my jurisdiction and was completed on (mo/day/year) 8/2001 and this record is true to the best of my knowledge and belief. Kansas Water Well Contractor's Licence No. 451 This Water Well Record was completed on (mo/day/yr) 12/8/2001 under the business name of Hakeman Well Drilling by (signature) Craig A. Caporale