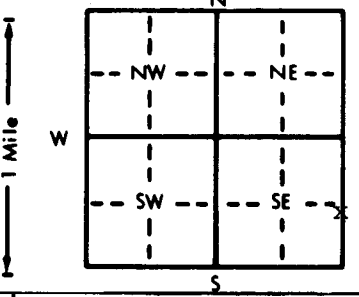


1 LOCATION OF WATER WELL: Fraction NE 1/4 SE 1/4 SE 1/4 Section Number 20 Township Number T 7 S Range Number R 4 **EW**
 County: Clay

Distance and direction from nearest town or city street address of well if located within city?
 Located near 6th and Martin St. Intersection, Green, KS

2 WATER WELL OWNER: City of Green
 RR#, St. Address, Box #: P.O. Box 25
 City, State, ZIP Code: Green, KS 67447
 Board of Agriculture, Division of Water Resources
 Application Number: not available

3 LOCATE WELL'S LOCATION WITH AN "X" IN SECTION BOX:

 4 DEPTH OF COMPLETED WELL: 150 ft. ELEVATION: unknown
 Depth(s) Groundwater Encountered 1. 83.2 ft. 2. ft. 3. ft.
 WELL'S STATIC WATER LEVEL: 83.2 ft. below land surface measured on mo/day/yr 12/11/86
 Pump test data: Well water was 120.4 ft. after 3 hours pumping 29.4 gpm
 Est. Yield 29 gpm: Well water was ft. after hours pumping gpm
 Bore Hole Diameter: 12 1/2 in. to 148 ft., and in. to ft.
 WELL WATER TO BE USED AS:
 5 Public water supply 8 Air conditioning 11 Injection well
 1 Domestic 3 Feedlot 6 Oil field water supply 9 Dewatering 12 Other (Specify below)
 2 Irrigation 4 Industrial 7 Lawn and garden only 10 Observation well
 Was a chemical/bacteriological sample submitted to Department? Yes.....No...X.....; If yes, mo/day/yr sample was submitted
 Water Well Disinfected? Yes No

5 TYPE OF BLANK CASING USED:
 1 Steel 3 RMP (SR) 5 Wrought iron 8 Concrete tile CASING JOINTS: Glued.....Clamped X.....
 2 PVC 4 ABS 6 Asbestos-Cement 9 Other (specify below) Welded.....
 7 Fiberglass Threaded.....
 Blank casing diameter 5 in. to 94 ft., Dia. in. to ft., Dia. in. to ft.
 Casing height above land surface 24 in., weight 2.788 lbs./ft. Wall thickness or gauge No. 265
 TYPE OF SCREEN OR PERFORATION MATERIAL:
 1 Steel a) 3 Stainless steel 5 Fiberglass 8 RMP (SR) 10 Asbestos-cement 11 Other (specify).....
 2 Brass 4 Galvanized steel 6 Concrete tile 9 ABS 12 None used (open hole)
 SCREEN OR PERFORATION OPENINGS ARE:
 1 Continuous slot 3 Mill slot 5 Gauzed wrapped 8 Saw cut 11 None (open hole)
 2 Louvered shutter 4 Key punched 6 Wire wrapped b) 9 Drilled holes
 7 Torch cut a) 10 Other (specify) 125 Cont. Wire Wound.
 SCREEN-PERFORATED INTERVALS: From b) 94 ft. to 133 ft., From a) 133 ft. to 143 ft.
 From b) 143 ft. to 148 ft., From ft. to ft.
 GRAVEL PACK INTERVALS: From 85 ft. to 148 ft., From ft. to ft.
 From ft. to ft.

6 GROUT MATERIAL: a) 1 Neat cement 2 Cement grout b) 3 Bentonite 4 Other.....
 Grout intervals: From a) 0 ft. to 20 ft., From b) 20 ft. to 85 ft., From ft. to ft.
 What is the nearest source of possible contamination:
 1 Septic tank 4 Lateral lines 7 Pit privy 10 Livestock pens 14 Abandoned water well
 2 Sewer lines 5 Cess pool 8 Sewage lagoon 11 Fuel storage 15 Oil well/Gas well
 3 Watertight sewer lines 6 Seepage pit 9 Feedyard 12 Fertilizer storage 16 Other (specify below)
 13 Insecticide storage None Apparent
 Direction from well? n/a How many feet?

FROM	TO	LITHOLOGIC LOG	FROM	TO	LITHOLOGIC LOG
0	63	Topsoil, shale, tan, limestone strks			
63	94	Shale, red & green w/limestone strks at 84'			
94	97	Limestone, white, tan w/strks shale white & tan			
97	102	Limestone-white, tan, hard 94-102'			
102	110	Shale, gray			
110	114	Shale, tan w/streak of limestone @ 111'			
114	116	Limestone, white w/white shale streaks			
116	118	Shale, white & tan			
118	134	Shale, red w/limestone strks @ 127', 131' and 132'			
134	140	Limestone, white shale streaks -white			
140	147	Limestone, white w/tan shale streaks			
147	148	Shale, gray			

7 CONTRACTOR'S OR LANDOWNER'S CERTIFICATION: This water well was (1) constructed, (2) reconstructed, or (3) plugged under my jurisdiction and was completed on (mo/day/year) 11/1/86. *See Note..... and this record is true to the best of my knowledge and belief. Kansas Water Well Contractor's License No. 185. This Water Well Record was completed on (mo/day/yr) 4/10/87 under the business name of Clarke Well & Equipment, Inc. by (signature) *Clarke Well & Equipment, Inc.*

INSTRUCTIONS: Use typewriter or ball point pen. PLEASE PRESS FIRMLY and PRINT clearly. Please fill in blanks, underline or circle the correct answers. Send top three copies to Kansas Department of Health and Environment, Office of Oil Field and Environmental Geology, Regulation and Permitting Section, Topeka, Kansas 66620-7500, Telephone: 913-862-9360. Send one to WATER WELL OWNER and retain one for your records.

*Total completion of this well did not occur until later date is reason this report was not complete until this date