


1 LOCATION OF WATER WELL: Fraction SW 1/4 NE 1/4 SE 1/4 Section Number 20 Township Number T 7 S Range Number R 4 **(EW)**  
 County: Clay

Distance and direction from nearest town or city street address of well if located within city?  
 Located on Stokes Street in Green, KS

2 WATER WELL OWNER: Green, City of  
 RR#, St. Address, Box #: Box 25  
 City, State, ZIP Code: Green, KS 67447  
 Board of Agriculture, Division of Water Resources  
 Application Number: not available

Well #7

3 LOCATE WELL'S LOCATION WITH AN "X" IN SECTION BOX:

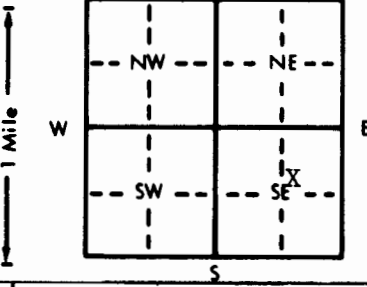

4 DEPTH OF COMPLETED WELL: 178 ft. ELEVATION:  
 Depth(s) Groundwater Encountered 1. 96.7 ft. 2. ft. 3. ft.  
 WELL'S STATIC WATER LEVEL: 96.7 ft. below land surface measured on mo/day/yr 12-11-86  
 Pump test data: Well water was 130.9 ft. after 2 hours pumping 14 gpm  
 Est. Yield 14 gpm: Well water was ft. after hours pumping gpm  
 Bore Hole Diameter: 12 1/4 in. to 176 ft., and in. to ft.  
 WELL WATER TO BE USED AS:  
 5 Public water supply 8 Air conditioning 11 Injection well  
 1 Domestic 3 Feedlot 6 Oil field water supply 9 Dewatering 12 Other (Specify below)  
 2 Irrigation 4 Industrial 7 Lawn and garden only 10 Observation well  
 Was a chemical/bacteriological sample submitted to Department? Yes NoX; If yes, mo/day/yr sample was submitted  
 Water Well Disinfected? Yes X No

5 TYPE OF BLANK CASING USED:  
 1 Steel 3 RMP (SR) 5 Wrought iron 8 Concrete tile CASING JOINTS: Glued Clamped X  
 2 PVC 4 ABS 6 Asbestos-Cement 9 Other (specify below) Welded  
 7 Fiberglass Threaded

Blank casing diameter 5 in. to 108 ft., Dia. in. to ft., Dia. in. to ft.  
 Casing height above land surface 24 in., weight 2,788 lbs./ft. Wall thickness or gauge No. 265

TYPE OF SCREEN OR PERFORATION MATERIAL:  
 1 Steel a) 3 Stainless steel 5 Fiberglass 8 RMP (SR) 10 Asbestos-cement  
 2 Brass 4 Galvanized steel 6 Concrete tile 9 ABS 11 Other (specify)  
 12 None used (open hole)

SCREEN OR PERFORATION OPENINGS ARE:  
 1 Continuous slot 3 Mill slot 5 Gauzed wrapped 8 Saw cut 11 None (open hole)  
 2 Louvered shutter 4 Key punched 6 Wire wrapped b) 9 Drilled holes  
 7 Torch cut a) 10 Other (specify) Continuous wire wound

SCREEN-PERFORATED INTERVALS: From a) 114 ft. to 129 ft., From ft. to ft.  
 From b) 108 ft. to 114 ft., From b) 129 ft. to 176 ft.  
 GRAVEL PACK INTERVALS: From 98 ft. to 176 ft., From ft. to ft.

6 GROUT MATERIAL: a) Neat cement 2 Cement grout b) 3 Bentonite 4 Other  
 Grout Intervals: From a) 0 ft. to 20 ft., From b) 20 ft. to 98 ft., From ft. to ft.

What is the nearest source of possible contamination:  
 1 Septic tank 4 Lateral lines 7 Pit privy 10 Livestock pens 14 Abandoned water well  
 2 Sewer lines 5 Cess pool 8 Sewage lagoon 11 Fuel storage 15 Oil well/Gas well  
 3 Watertight sewer lines 6 Seepage pit 9 Feedyard 12 Fertilizer storage 16 Other (specify below)  
 13 Insecticide storage NONE APPARENT

Direction from well? n/a How many feet?

FROM	TO	LITHOLOGIC LOG	FROM	TO	LITHOLOGIC LOG
0	8	Topsoil & brown clay	161	175	Limestone, white & tan
8	88	Shale, tan, yellow & green w/strks of limestone	175	176 1/9	Shale, - gray
88	100	Shale, green & red			
100	103	Shale, dark red			
103	115	Shale, green & red w/streak of limestone At 110'			
115	129	Limestone, tan & brown w/streaks of tan shale, 124.5', real soft streak			
129	135	Shale, tan & green, w/lot of streaks of limestone			
135	139	Tan shale			
139	140	Hard limestone			
140	142	Shale - green & tan			
142	161	Soft red shale			

7 CONTRACTOR'S OR LANDOWNER'S CERTIFICATION: This water well was (1) constructed, (2) reconstructed, or (3) plugged under my jurisdiction and was completed on (mo/day/year) 11/22/86. (See Note)\* and this record is true to the best of my knowledge and belief. Kansas Water Well Contractor's License No. 185 This Water Well Record was completed on (mo/day/yr) 4/10/87 under the business name of Clarke Well & Equipment, Inc. by (signature) [Signature]

INSTRUCTIONS: Use typewriter or ball point pen. PLEASE PRESS FIRMLY and PRINT clearly. Please fill in blanks, underline or circle the correct answers. Send top three copies to Kansas Department of Health and Environment, Office of Oil Field and Environmental Geology, Regulation and Permitting Section, Topeka, Kansas 66620-7500, Telephone: 913-862-9360. Send one to WATER WELL OWNER and retain one for your records.

\*Total completion of this well did not occur until later date is reason this report was not completed until this date

OFFICE USE ONLY  
T  
R  
EW  
SEC.  
1/4  
1/4  
1/4