


1 LOCATION OF WATER WELL: County: Clay Fraction: NE $\frac{1}{4}$ $\frac{1}{4}$ $\frac{1}{4}$ Section Number: 20 Township Number: T 7 S Range Number: R 4 E/W

Distance and direction from nearest town or city street address of well if located within city?
in City of Green

2 WATER WELL OWNER: James Lippert *Lot 1 in the northeast quarter (NE 1/4) of section (20) Township (7) South Range (4) East of the (18) P.M. Board of Agriculture, Division of Water Resources*
 RR#, St. Address, Box #: Green, KS 67447 *except the east 245 feet of said Lot one*
 City, State, ZIP Code: Green, KS 67447 Application Number: _____

3 LOCATE WELL'S LOCATION WITH AN "X" IN SECTION BOX:

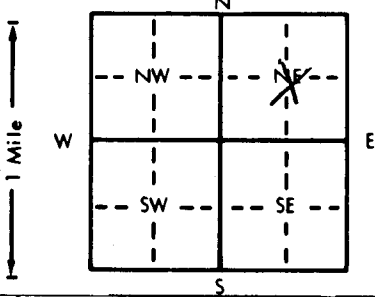

4 DEPTH OF COMPLETED WELL: 204 ft. ELEVATION: _____

Depth(s) Groundwater Encountered 1. _____ ft. 2. _____ ft. 3. _____ ft.
 WELL'S STATIC WATER LEVEL 130 ft. below land surface measured on mo/day/yr 5-25-84
 Pump test data: Well water was _____ ft. after _____ hours pumping _____ gpm
 Est. Yield 100+ gpm: Well water was _____ ft. after _____ hours pumping _____ gpm
 Bore Hole Diameter 8 in. to 204 ft., and 10" in. to 20' ft.
 WELL WATER TO BE USED AS:
 5 Public water supply 8 Air conditioning 11 Injection well
1 Domestic 3 Feedlot 6 Oil field water supply 9 Dewatering 12 Other (Specify below)
 2 Irrigation 4 Industrial 7 Lawn and garden only 10 Observation well
 Was a chemical/bacteriological sample submitted to Department? Yes _____ No X; If yes, mo/day/yr sample was submitted _____
 Water Well Disinfected? Yes _____ No _____

5 TYPE OF BLANK CASING USED:
 1 Steel 3 RMP (SR) 5 Wrought iron 8 Concrete tile CASING JOINTS: Glued _____ Clamped _____
 2 PVC 4 ABS 6 Asbestos-Cement 9 Other (specify below) Welded _____
 7 Fiberglass _____ Threaded _____

Blank casing diameter 5 in. to _____ ft., Dia _____ in. to _____ ft., Dia _____ in. to _____ ft.
 Casing height above land surface 12 in., weight 200 lbs./ft. Wall thickness or gauge No. 200

TYPE OF SCREEN OR PERFORATION MATERIAL:
 1 Steel 3 Stainless steel 5 Fiberglass 7 PVC 10 Asbestos-cement
 2 Brass 4 Galvanized steel 6 Concrete tile 8 RMP (SR) 11 Other (specify) _____
 9 ABS 12 None used (open hole)

SCREEN OR PERFORATION OPENINGS ARE:
 1 Continuous slot 3 Mill slot 5 Gauzed wrapped 8 Saw cut 11 None (open hole)
 2 Louvered shutter 4 Key punched 6 Wire wrapped 9 Drilled holes
 7 Torch cut 10 Other (specify) _____

SCREEN-PERFORATED INTERVALS: From 184 ft. to 204 ft., From _____ ft. to _____ ft.
 From _____ ft. to _____ ft., From _____ ft. to _____ ft.
 GRAVEL PACK INTERVALS: From 150 ft. to 204 ft., From _____ ft. to _____ ft.
 From _____ ft. to _____ ft., From _____ ft. to _____ ft.

6 GROUT MATERIAL: 1 Neat cement 2 Cement grout 3 Bentonite 4 Other _____
 Grout Intervals: From 0 ft. to 50 ft., From _____ ft. to _____ ft., From _____ ft. to _____ ft.

What is the nearest source of possible contamination:
 1 Septic tank 4 Lateral lines 7 Pit privy 10 Livestock pens 14 Abandoned water well
 2 Sewer lines 5 Cess pool 8 Sewage lagoon 11 Fuel storage 15 Oil well/Gas well
 3 Watertight sewer lines 6 Seepage pit 9 Feedyard 12 Fertilizer storage 16 Other (specify below)
 13 Insecticide storage _____
 Direction from well? South How many feet? 100

| FROM | TO | LITHOLOGIC LOG | FROM | TO | LITHOLOGIC LOG |
|------|-----|-----------------------------|------|----|----------------|
| 0 | 4 | Top Soil | | | |
| 4 | 93 | Yellow, red, & White Shale | | | |
| 93 | 104 | Lime (little water) | | | |
| 104 | 112 | Gray Shale | | | |
| 112 | 118 | Yellow Shale | | | |
| 118 | 132 | Red Shale | | | |
| 132 | 140 | White Shale | | | |
| 140 | 151 | Lime & Shale (little water) | | | |
| 151 | 172 | Gray Shale | | | |
| 172 | 182 | Red Shale | | | |
| 182 | 202 | Soft Lime | | | |
| 202 | 204 | Shale | | | |

7 CONTRACTOR'S OR LANDOWNER'S CERTIFICATION: This water well was (1) constructed, (2) reconstructed, or (3) plugged under my jurisdiction and was completed on (mo/day/year) 5-25-84 and this record is true to the best of my knowledge and belief. Kansas Water Well Contractor's License No. 2348 This Water Well Record was completed on (mo/day/yr) 5-25-84 under the business name of Blue Valley Drilling by (signature) Derald Strader

INSTRUCTIONS: Use typewriter or ball point pen, PLEASE PRESS FIRMLY and PRINT clearly. Please fill in blanks, underline or circle the correct answers. Send top three copies to Kansas Department of Health and Environment, Division of Environment, Environmental Geology Section, Topeka, KS 66620. Send one to WATER WELL OWNER and retain one for your records.

OFFICE USE ONLY

7

4

25

SEC. 20

NE 1/4

1/4

1/4

