


1 LOCATION OF WATER WELL: Fraction NW 1/4 SW 1/4 SE 1/4 Section Number 33 Township Number T 7 S Range Number R 5 EAV

County: RELEY Distance and direction from nearest town or city street address of well if located within city?

2 MILES NORTH AND 1/2 MILE WEST OF LEONARDVILLE, KS.

2 WATER WELL OWNER: BRANDON & LAURIE ROBBE RR#, St. Address, Box #: P.O. BOX 59 Board of Agriculture, Division of Water Resources
 City, State, ZIP Code: LEONARDVILLE, KS. 66449 Application Number: _____

3 LOCATE WELL'S LOCATION WITH AN "X" IN SECTION BOX:

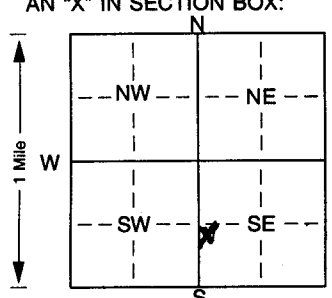

4 DEPTH OF COMPLETED WELL: 160 ft. ELEVATION: _____
 Depth(s) Groundwater Encountered 1. 120 ft. 2. _____ ft. 3. _____ ft.
 WELL'S STATIC WATER LEVEL: 116 ft. below land surface measured on mo/day/yr 2/22/01
 Pump test data: Well water was _____ ft. after _____ hours pumping _____ gpm
 Est. Yield 60+ gpm: Well water was _____ ft. after _____ hours pumping _____ gpm
 Bore Hole Diameter: 8.75 in. to 16.0 ft., and _____ in. to _____ ft.
 WELL WATER TO BE USED AS: 5 Public water supply 8 Air conditioning 11 Injection well
 Domestic 3 Feedlot 6 Oil field water supply 9 Dewatering 12 Other (Specify below)
 Irrigation 4 Industrial 7 Domestic (lawn & garden) 10 Monitoring well
 Was a chemical/bacteriological sample submitted to Department? Yes. _____ No. ; If yes, mo/day/yrs sample was submitted _____
 Water Well Disinfected? Yes No _____

5 TYPE OF BLANK CASING USED: 5 Wrought iron 8 Concrete tile CASING JOINTS: Glued Clamped _____
 1 Steel 3 RMP (SR) 6 Asbestos-Cement 9 Other (specify below) Welded _____
 PVC 4 ABS 7 Fiberglass _____ Threaded _____
 Blank casing diameter 5 in. to 120 ft., Dia _____ in. to _____ ft., Dia _____ in. to _____ ft.
 Casing height above land surface 18 in., weight _____ lbs./ft. Wall thickness or gauge No. SDR 26
 TYPE OF SCREEN OR PERFORATION MATERIAL: PVC 10 Asbestos-cement
 1 Steel 3 Stainless steel 5 Fiberglass 8 RMP (SR) 11 Other (specify) _____
 2 Brass 4 Galvanized steel 6 Concrete tile 9 ABS 12 None used (open hole)
 SCREEN OR PERFORATION OPENINGS ARE: 5 Gauzed wrapped 8 Saw cut 11 None (open hole)
 1 Continuous slot Mill slot .030 6 Wire wrapped 9 Drilled holes
 2 Louvered shutter 4 Key punched 7 Torch cut 10 Other (specify) _____ ft.
 SCREEN-PERFORATED INTERVALS: From 150 ft. to 160 ft., From _____ ft. to _____ ft.
 From 120 ft. to 130 ft., From _____ ft. to _____ ft.
 GRAVEL PACK INTERVALS: From 25 ft. to 160 ft., From _____ ft. to _____ ft.
 From _____ ft. to _____ ft., From _____ ft. to _____ ft.

6 GROUT MATERIAL: 1 Neat cement 2 Cement grout Bentonite 4 Other _____
 Grout Intervals: From 0 ft. to 25 ft., From _____ ft. to _____ ft., From _____ ft. to _____ ft.
 What is the nearest source of possible contamination: 10 Livestock pens Abandoned water well
 1 Septic tank 4 Lateral lines 7 Pit privy 11 Fuel storage 15 Oil well/Gas well
 2 Sewer lines 5 Cess pool 8 Sewage lagoon 12 Fertilizer storage 16 Other (specify below)
 3 Watertight sewer lines 6 Seepage pit 9 Feedyard 13 Insecticide storage
 Direction from well? SOUTHWEST How many feet? 75

FROM	TO	LITHOLOGIC LOG	FROM	TO	PLUGGING INTERVALS
0	6	CLAY			
6	10	LIMESTONE, YELLOW			
10	29	SHALE, TAN			
29	50	SHALE, RED			
50	61	LIMESTONE, TAN			
61	120	SHALE, TAN, GRAY TO RED			
120	133	LIMESTONE, TAN, SATURATED			
133	141	SHALE, GRAY			
141	143	GYP SUM			
143	149	SHALE, GRAY			
149	151	LIMESTONE, YELLOW			
151	160	SHALE, LIGHT GRAY			
	160	TOTAL DEPTH			

7 CONTRACTOR'S OR LANDOWNER'S CERTIFICATION: This water well was constructed, (2) reconstructed, or (3) plugged under my jurisdiction and was completed on (mo/day/year) 2/22/01 and this record is true to the best of my knowledge and belief. Kansas Water Well Contractor's Licence No. 585 This Water Well Record was completed on (mo/day/yr) 2/27/01 under the business name of Associated Landowners Inc. by (signature) _____