

9

USE TYPEWRITER OR BALL POINT PEN PRESS FIRMLY BUT NOT TOO HARD

WATER WELL RECORD
KSA 82a-1201-1215


Kansas Department of Health and Environment-Division of Environment
(Water well Contractors)
Topeka, Kansas 66620

1. Location of well: **Valley**

Fraction: **SW 1/4 SW 1/4 NW 1/4** Section number: **19** Township number: **T 7 S R 5** Range number: **5** (E/W)

2. Distance and direction from nearest town or city: **5-0.23 W of Leonardville Ks.**
Street address of well location if in city: **1 N 1/2 E**

3. Owner of well: **Wallace Johnson**
R.R. or street:
City, state, zip code: **Leonardville Ks**

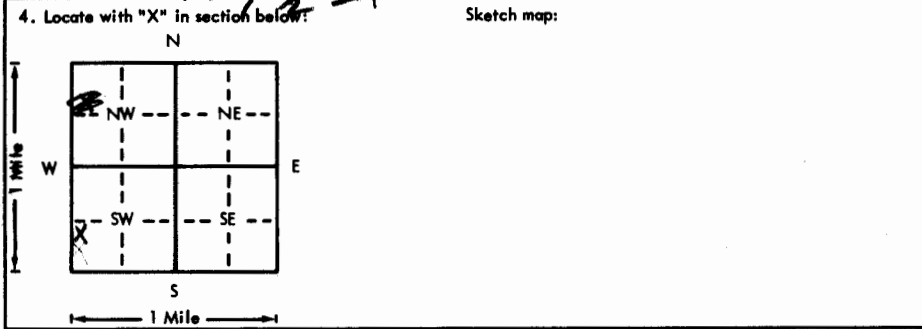

6. Bore hole dia. **8** in. Completion date **11-10-76**
Well depth **75** ft.

7. Cable tool Rotary Driven Dug
 Hollow rod Jetted Bored Reverse rotary

8. Use: Domestic Public supply Industry Stock
 Irrigation Air conditioning Lawn Oil field water Other

9. Casing: Material **Pist** Height: **Above** or below
Threaded Welded **Ghpc** Surface **18** in.
RMP PVC Weight _____ lbs./ft.
Dia. **5** in. to **75** ft. depth Wall Thickness: inches or
Dia. _____ in. to _____ ft. depth Gage No. **Sch 40**

5. Type and color of material	From	To
Dirt Black	0	2
Clay yellow	2	8
Lime Rock White	8	10
Clay "	10	15
" Brown	15	50
Lime Rock White Porous	50	55
" " " "	55	65
Clay Blue	65	75

10. Screen: Manufacturer's name **Pumpco**
Type **PVC** Dia. **5"**
Slot/gauze **1/8"** Length **30'**
Set between **55** ft. and **75** ft.
Gravel pack? **Yes** Size range of material **1/8-1/2"**

11. Static water level: _____ mo./day/yr.
21 ft. below land surface Date **11-10-76**

12. Pumping level below land surfaces:
_____ ft. after _____ hrs. pumping _____ g.p.m.
_____ ft. after _____ hrs. pumping _____ g.p.m.
Estimated maximum yield _____ g.p.m.

13. Water sample submitted: _____ mo./day/yr.
Yes No Date **11-10-76**

14. Well head completion:
 Pitless adapter **24"** inches above grade

15. Well grouted? **Yes**
With: Neat cement Bentonite Concrete
Depth: From **6** ft. to **15** ft.

16. Nearest source of possible contamination:
ft. **200'** Direction **SW** Type **Stock Ponds**
Well disinfected upon completion? Yes No

17. Pump: Not installed
Manufacturer's name _____ HP _____ Volts _____
Length of drop pipe _____ ft. capacity _____ g.p.m.
Type:
 Submersible Turbine
 Jet Reciprocating
 Centrifugal Other

18. Elevation: **1238**

19. Remarks: **Cement Slab To Be Poured By Land owner**

20. Water well contractor's certification:
This well was drilled under my jurisdiction and this report is true to the best of my knowledge and belief.
Harper Well Service 76
Business name License No. _____
Address **Blue Rapids Ks.**
Signed **Tom Harper** Date **11-10-76**
Authorized representative

T-7-5W-12-1/4-1/4-1/4