


1 LOCATION OF WATER WELL: Fraction NW 1/4 NE 1/4 NW 1/4 Section Number 25 Township Number T 7 S Range Number R 5 E/W
 County: RILEY
 Distance and direction from nearest town or city street address of well if located within city? FROM RILEY 60 4 MILES NORTH ON 24 TO FALCON ROAD + GO 4 MILES NORTH TO SKOW + 1/4 EAST

2 WATER WELL OWNER: ROD TROYER
 RR#, St. Address, Box #: RR1 BOX 36 Board of Agriculture, Division of Water Resources
 City, State, ZIP Code: LEONARDVILLE KS 66449 Application Number:

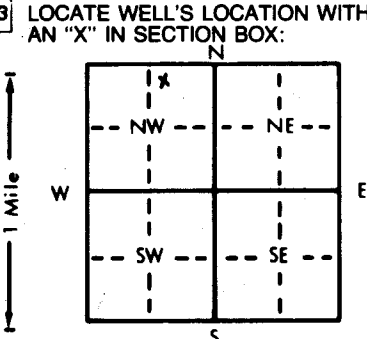

4 DEPTH OF COMPLETED WELL: 90 ft. ELEVATION:
 Depth(s) Groundwater Encountered 1. 53 ft. 2. ft. 3. ft.
 WELL'S STATIC WATER LEVEL: 27 ft. below land surface measured on mo/day/yr
 Pump test data: Well water was ft. after hours pumping gpm
 Est. Yield 5 1/2 gpm: Well water was ft. after hours pumping gpm
 Bore Hole Diameter: 9 in. to 80 ft., and in. to ft.
 WELL WATER TO BE USED AS:
 1 Domestic 3 Feedlot 6 Oil field water supply 9 Dewatering 12 Other (Specify below)
 2 Irrigation 4 Industrial 7 Lawn and garden only 10 Monitoring well
 Was a chemical/bacteriological sample submitted to Department? Yes.....No.....; If yes, mo/day/yr sample was submitted
 Water Well Disinfected? Yes No SCREENED Clamped

5 TYPE OF BLANK CASING USED:
 1 Steel 3 RMP (SR) 5 Wrought iron 8 Concrete tile
 2 PVC 4 ABS 6 Asbestos-Cement 9 Other (specify below)
 7 Fiberglass
 Blank casing diameter: 5 in. to 60 ft., Dia. in. to ft., Dia. in. to ft.
 Casing height above land surface: 2 in., weight SCH. 40 lbs./ft. Wall thickness or gauge No.
 TYPE OF SCREEN OR PERFORATION MATERIAL:
 1 Steel 3 Stainless steel 5 Fiberglass 8 RMP (SR) 10 Asbestos-cement
 2 Brass 4 Galvanized steel 6 Concrete tile 9 ABS 11 Other (specify)
 12 None used (open hole)
 SCREEN OR PERFORATION OPENINGS ARE:
 1 Continuous slot 3 Mill slot 31/1000 5 Gauzed wrapped 8 Saw cut 11 None (open hole)
 2 Louvered shutter 4 Key punched 6 Wire wrapped 9 Drilled holes
 7 Torch cut 10 Other (specify)
 SCREEN-PERFORATED INTERVALS: From 60 ft. to 80 ft., From ft. to ft.
 From ft. to ft., From ft. to ft.
 GRAVEL PACK INTERVALS: From 20 ft. to 80 ft., From ft. to ft.
 From ft. to ft., From ft. to ft.

6 GROUT MATERIAL: 1 Neat cement 2 Cement grout 3 Bentonite 4 Other
 Grout intervals: From 0 ft. to 20 ft., From ft. to ENVIRONMENTAL ft., From ft. to ft.
 What is the nearest source of possible contamination:
 1 Septic tank 4 Lateral lines 7 Pit privy 10 Livestock pens 14 Abandoned water well
 2 Sewer lines 5 Cess pool 8 Sewage lagoon 11 Fuel storage 15 Oil well/Gas well
 3 Watertight sewer lines 6 Seepage pit 9 Feedyard 12 Fertilizer storage 16 Other (specify below)
 13 Insecticide storage
 Direction from well? SOUTH EAST How many feet? 150

FROM	TO	LITHOLOGIC LOG	FROM	TO	PLUGGING INTERVALS
0	2	TOP SOIL			
2	15	BROWN CLAY			
15	31	REDDISH GRAY SHALE			
31	44	BROWN SHALE			
44	53	LIME STONE			
53	56	BROWN SHALE			
56	62	LIME STONE			
62	80	GRAY SHALE			

7 CONTRACTOR'S OR LANDOWNER'S CERTIFICATION: This water well was (1) constructed (2) reconstructed, or (3) plugged under my jurisdiction and was completed on (mo/day/year) 10/2/90 and this record is true to the best of my knowledge and belief. Kansas Water Well Contractor's License No. 451 This Water Well Record was completed on (mo/day/yr) 10/23/90 under the business name of HALDEMAN WELL DRILLING by (signature) Craig C. Halde

OFFICE USE ONLY
T
R
E/W
SEC.