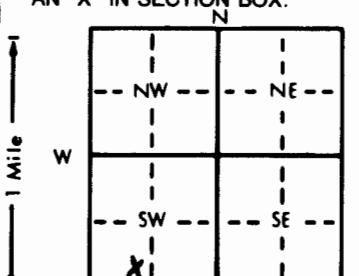


1 LOCATION OF WATER WELL: County: Pikay Fraction: SE 1/4 SW 1/4 SW 1/4 Section Number: 34 Township Number: T 7 S Range Number: R 5 E

Distance and direction from nearest town or city street address of well if located within city? From Leonardville Mo 2 miles North on 875 To Walsburg Road + Go 1/2 mile West

2 WATER WELL OWNER: STEV STRAUSS  
 RR#, St. Address, Box #: RR#1 Box 45  
 City, State, ZIP Code: Leonardville, KS 66449  
 Board of Agriculture, Division of Water Resources  
 Application Number:

3 LOCATE WELL'S LOCATION WITH AN "X" IN SECTION BOX:  4 DEPTH OF COMPLETED WELL: 120' ft. ELEVATION:  
 Depth(s) Groundwater Encountered 1. 73 ft. 2. ft. 3. ft.  
 WELL'S STATIC WATER LEVEL: 70 ft. below land surface measured on mo/day/yr  
 Pump test data: Well water was ft. after hours pumping gpm  
 Est. Yield: 20 gpm; Well water was ft. after hours pumping gpm  
 Bore Hole Diameter: 9 in. to 120 ft. and in. to ft.  
 WELL WATER TO BE USED AS:  
 1 Domestic  3 Feedlot  6 Oil field water supply  9 Dewatering  12 Other (Specify below)  
 2 Irrigation  4 Industrial  7 Lawn and garden only  10 Monitoring well  
 Was a chemical/bacteriological sample submitted to Department? Yes.....No.....; If yes, mo/day/yr sample was submitted

5 TYPE OF BLANK CASING USED:  
 1 Steel  3 RMP (SR)  5 Wrought iron  8 Concrete tile  CASING JOINTS:  Glued  Screwed  Clamped  
 2 PVC  4 ABS  6 Asbestos-Cement  9 Other (specify below)  Welded  
 Blank casing diameter: 5 in. to 100 ft., Dia. in. to ft., Dia. in. to ft.  
 Casing height above land surface: 2' in., weight Sch 40 lbs./ft. Wall thickness or gauge No.  
 TYPE OF SCREEN OR PERFORATION MATERIAL:  
 1 Steel  3 Stainless steel  5 Fiberglass  7 PVC  10 Asbestos-cement  
 2 Brass  4 Galvanized steel  6 Concrete tile  9 ABS  11 Other (specify)  
 SCREEN OR PERFORATION OPENINGS ARE:  
 1 Continuous slot  3 Mill slot 3/1,000's  5 Gauzed wrapped  8 Saw cut  11 None (open hole)  
 2 Louvered shutter  4 Key punched  6 Wire wrapped  9 Drilled holes  
 SCREEN-PERFORATED INTERVALS: From 100 ft. to 120 ft., From ft. to ft.  
 GRAVEL PACK INTERVALS: From 25 ft. to 120 ft., From ft. to ft.

6 GROUT MATERIAL:  1 Neat cement  2 Cement grout  3 Bentonite  4 Other  
 Grout Intervals: From 0 ft. to 25 ft., From ft. to ENVIRONMENTAL ft., From ft. to ft.  
 What is the nearest source of possible contamination:  
 1 Septic tank  4 Lateral lines  7 Pit privy  10 Livestock pens  14 Abandoned water well  
 2 Sewer lines  5 Cess pool  8 Sewage lagoon  11 Fuel storage  15 Oil well/Gas well  
 3 Watertight sewer lines  6 Seepage pit  9 Feedyard  12 Fertilizer storage  16 Other (specify below)  
 13 Insecticide storage  
 Direction from well? 100' How many feet? SOUTH

FROM	TO	LITHOLOGIC LOG	FROM	TO	PLUGGING INTERVALS
0	3	Brown clay			
3	4	Limestone			
4	15	Brown CLAY			
15	18	Limestone			
18	29	Greenish shale			
29	30	Limestone			
30	36	Greenish shale			
36	73	Brown shale			
73	94	Limestone (WATER)			
94	106	Greenish Shale			
106	110	Limestone			
110	120	Gory shale			

7 CONTRACTOR'S OR LANDOWNER'S CERTIFICATION: This water well was  (1) constructed  (2) reconstructed, or  (3) plugged under my jurisdiction and was completed on (mo/day/year) 5/13/91 and this record is true to the best of my knowledge and belief. Kansas Water Well Contractor's License No. 451 This Water Well Record was completed on (mo/day/yr) 5/28/91 under the business name of HALDAMAN WELL DRILLING by (signature) Craig H. CWD/PE

OFFICE USE ONLY  
T  
R  
EM  
SEC.