


1 LOCATION OF WATER WELL: County: Riley Fraction: SW 1/4 SW 1/4 SE 1/4 Section Number: 34 Township Number: T 07 S Range Number: R 06 E

Distance and direction from nearest town or city street address of well if located within city? Mills south on 177 + 60 3/4 mile west ~~From~~ From Randolph Co 2

2 WATER WELL OWNER: Gerald Jones Riley Co Permit # 95,152
 RR#, St. Address, Box #: 426 South Nebraska P.O. Box 176
 City, State, ZIP Code: WATERVILLE, KS
 Board of Agriculture, Division of Water Resources
 Application Number:

3 LOCATE WELL'S LOCATION WITH AN "X" IN SECTION BOX:

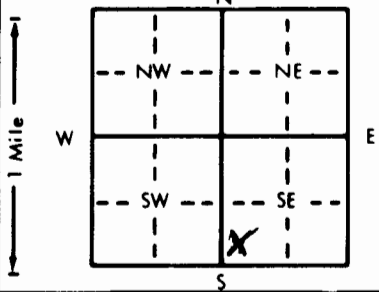

4 DEPTH OF COMPLETED WELL: 100 ft. ELEVATION:

Depth(s) Groundwater Encountered 1. 53 ft. 2. ft. 3. ft.
 WELL'S STATIC WATER LEVEL 50 ft. below land surface measured on mo/day/yr
 Pump test data: Well water was ft. after hours pumping gpm
 Est. Yield 12 gpm; Well water was ft. after hours pumping gpm
 Bore Hole Diameter 9 in. to 100 ft., and in. to ft.
 WELL WATER TO BE USED AS:
 Domestic 3 Feedlot 6 Oil field water supply 9 Dewatering 12 Other (Specify below)
 2 Irrigation 4 Industrial 7 Lawn and garden only 10 Monitoring well
 Was a chemical/bacteriological sample submitted to Department? Yes No; If yes, mo/day/yr sample was submitted
 Water Well Disinfected: Yes No

5 TYPE OF BLANK CASING USED: 1 Steel 2 PVC 3 RMP (SR) 4 ABS 5 Wrought iron 6 Asbestos-Cement 7 Fiberglass 8 Concrete tile 9 Other (specify below) CASING JOINTS: Glued Clamped Welded Threaded

Blank casing diameter 5 in. to 80 ft. Dia. in. to ft. Dia. in. to ft.
 Casing height above land surface 2 in., weight 56 lb 41 lbs./ft. Wall thickness or gauge No.
 TYPE OF SCREEN OR PERFORATION MATERIAL:
 1 Steel 3 Stainless steel 5 Fiberglass 7 PVC 8 RMP (SR) 10 Asbestos-cement
 2 Brass 4 Galvanized steel 6 Concrete tile 9 ABS 11 Other (specify) 12 None used (open hole)

SCREEN OR PERFORATION OPENINGS ARE:
 1 Continuous slot 2 Mill slot 25/1000 3 Gauzed wrapped 4 Saw cut 5 None (open hole)
 2 Louvered shutter 4 Key punched 6 Wire wrapped 7 Drilled holes 9 Other (specify)
 3 Torch cut 10 Other (specify)

SCREEN-PERFORATED INTERVALS: From 80 ft. to 100 ft. From ft. to ft. From ft. to ft.
 GRAVEL PACK INTERVALS: From 25 ft. to 100 ft. From ft. to ft. From ft. to ft.

6 GROUT MATERIAL: 1 Neat cement 2 Cement grout 3 Bentonite 4 Other
 Grout Intervals: From 0 ft. to 25 ft. From ft. to ft. From ft. to ft.

What is the nearest source of possible contamination:
 1 Septic tank 4 Lateral lines Pit privy None close
 2 Sewer lines 5 Cess pool 8 Sewage lagoon
 3 Watertight sewer lines 6 Seepage pit 9 Feedyard
 10 Livestock pens 14 Abandoned water well
 11 Fuel storage 15 Oil well/Gas well
 12 Fertilizer storage 16 Other (specify below)
 13 Insecticide storage

Direction from well? How many feet?

FROM	TO	LITHOLOGIC LOG	FROM	TO	PLUGGING INTERVALS
0	1	Top Soil			
1	6	Yellow Shale			
6	8	Limestone			
8	21	Yellow Shale			
21	31	Greenish Shale			
31	44	Limestone			
44	53	Grey Shale			
53	56	Limestone (Water)			
56	75	Grey Shale			
75	81	Limestone			
81	87	Greenish Shale			
87	98	Limestone			
98	100	Tan Shale			

7 CONTRACTOR'S OR LANDOWNER'S CERTIFICATION: This water well was (1) constructed, (2) reconstructed, or (3) plugged under my jurisdiction and was completed on (mo/day/year) 11/30/95 and this record is true to the best of my knowledge and belief. Kansas Water Well Contractor's License No. 451 This Water Well Record was completed on (mo/day/yr) 12/10/95 under the business name of Haldeman Well Drilling by (signature) Craig H. Cupper