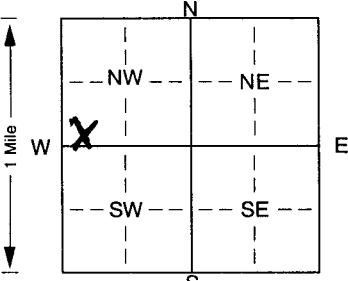


1 LOCATION OF WATER WELL: County: Riley Fraction: SW 1/4 SW 1/4 SW 1/4 Section Number: 17 Township Number: T 7 S Range Number: R 6 EW

Distance and direction from nearest town or city street address of well if located within city? From Randolph Co 1 M.I. West on Green Rd + Thru Co 1/2 mile North on Green Rd.

2 WATER WELL OWNER: RR#, St. Address, Box #: Joy Woodworth 15200 Walnut Creek Rd. Randolph, Mo 64554 Board of Agriculture, Division of Water Resources Application Number:

3 LOCATE WELL'S LOCATION WITH AN "X" IN SECTION BOX:  DEPTH OF COMPLETED WELL: 120 ft. ELEVATION: 72 ft.

Depth(s) Groundwater Encountered: 1 72 ft. 2. ft. 3. ft.

WELL'S STATIC WATER LEVEL: 60 ft. below land surface measured on mo/day/yr

Pump test data: Well water was ft. after hours pumping gpm

Est. Yield 22.5 gpm: Well water was ft. after hours pumping gpm

Bore Hole Diameter: in. to ft., and in. to ft.

WELL WATER TO BE USED AS: 1 Domestic 2 Irrigation 3 Feedlot 4 Industrial 5 Public water supply 6 Oil field water supply 7 Domestic (lawn & garden) 8 Air conditioning 9 Dewatering 10 Monitoring well 11 Injection well 12 Other (Specify below)

Was a chemical/bacteriological sample submitted to Department? Yes. No. ; If yes, mo/day/yr sample was submitted

Water Well Disinfected? Yes No

5 TYPE OF BLANK CASING USED: 1 Steel 2 PVC 3 RMP (SR) 4 ABS 5 Wrought iron 6 Asbestos-Cement 7 Fiberglass 8 Concrete tile 9 Other (specify below) CASING JOINTS: Glued Clamped Welded Threaded

Blank casing diameter: 5 in. to 100 ft., Dia. in. to ft., Dia. in. to ft.

Casing height above land surface: 26 in., weight 569.40 lbs./ft. Wall thickness or gauge No.

TYPE OF SCREEN OR PERFORATION MATERIAL: 1 Steel 2 Brass 3 Stainless steel 4 Galvanized steel 5 Fiberglass 6 Concrete tile 7 PVC 8 RMP (SR) 9 ABS 10 Asbestos-cement 11 Other (specify) 12 None used (open hole)

SCREEN OR PERFORATION OPENINGS ARE: 1 Continuous slot 2 Mill slot 25/100 3 Key punched 4 Gauzed wrapped 5 Wire wrapped 6 Torch cut 7 Saw cut 8 Drilled holes 9 None (open hole) 10 Other (specify) ft.

SCREEN-PERFORATED INTERVALS: From: 100 ft. to 120 ft., From ft. to ft.

GRAVEL PACK INTERVALS: From: 25 ft. to 120 ft., From ft. to ft.

6 GROUT MATERIAL: 1 Neat cement 2 Cement grout 3 Bentonite 4 Other

Grout Intervals: From: 5 ft. to 25 ft., From ft. to ft., From ft. to ft.

What is the nearest source of possible contamination: 1 Septic tank 2 Sewer lines 3 Watertight sewer lines 4 Lateral lines 5 Cess pool 6 Seepage pit 7 Pit privy 8 Sewage lagoon 9 Feedyard 10 Livestock pens 11 Fuel storage 12 Fertilizer storage 13 Insecticide storage 14 Abandoned water well 15 Oil well/Gas well 16 Other (specify below)

Direction from well? How many feet?

FROM	TO	LITHOLOGIC LOG	FROM	TO	PLUGGING INTERVALS
0	1	Top Soil			
1	7	Yellow shale			
7	15	limestone			
15	36	Brown shale			
36	42	Grey shale			
42	51	limestone			
51	72	Grey shale			
72	91	limestone			
91	102	Tan shale			
102	110	limestone			
110	120	Grey shale			

7 CONTRACTOR'S OR LANDOWNER'S CERTIFICATION: This water well was (1) constructed, (2) reconstructed, or (3) plugged under my jurisdiction and was completed on (mo/day/year) 8/9/2001 and this record is true to the best of my knowledge and belief. Kansas Water Well Contractor's Licence No. 451 This Water Well Record was completed on (mo/day/yr) 9/1/2001 under the business name of Holdeman Well Drilling + Pump Service by (signature) Craig J. Cooper