


1 LOCATION OF WATER WELL:	Fraction	Section Number	Township Number	Range Number
County: <u>RILEY</u>	<u>SP 1/4 SW 1/4 NW 1/4</u>	<u>32</u>	<u>7</u>	<u>6E</u>

Distance and direction from nearest town or city street address of well if located within city?
2 MILES SOUTH AND 1 WEST OF RANDOLPH, KS.

2 WATER WELL OWNER: <u>STEVIE HARGRAVE</u>	Board of Agriculture, Division of Water Resources
RR #, St. Address, Box #: <u>10051 SENN RD</u>	Application Number: _____
City, State, ZIP Code: <u>RANDOLPH KS 66554</u>	

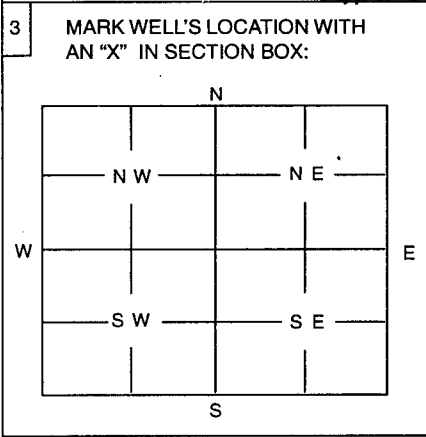

4 DEPTH OF WELL 76.5 ft

WELL'S STATIC WATER LEVEL 40.5 ft.

WELL WAS USED AS:

<input checked="" type="checkbox"/> 1 Domestic	5 Public Water Supply	9 Dewatering
<input type="checkbox"/> 2 Irrigation	6 Oil Field Water Supply	10 Monitoring Well
<input type="checkbox"/> 3 Feedlot	7 Domestic (Lawn & Garden)	11 Injection Well
<input type="checkbox"/> 4 Industrial	8 Air Conditioning	12 Other

Was a chemical / bacteriological sample submitted to Department? Yes No
 If yes, mo/day/yr sample was submitted

Water Well Disinfected: Yes No

5 TYPE OF BLANK CASING USED:

1 Steel	3 RMP (SR)	5 Wrought	7 Fiberglass	<input checked="" type="checkbox"/> 9 Other (Specify below)
2 PVC	4 ABS	6 Asbestos-Cement	8 Concrete Tile	<u>STAINLESS STEEL</u>

Blank casing diameter 5 in. Was casing pulled? Yes No If yes, how much

Casing height above or below land surface 0 in.

6 GROUT PLUG MATERIAL: 1 Neat cement 2 Cement grout Bentonite 4 Other

Grout Plug Intervals: From 0 ft. to 76.5 ft., From _____ ft. to _____ ft., From _____ to _____ ft.

What is the nearest source of possible contamination:

1 Septic tank	6 Seepage pit	11 Fuel storage	<input checked="" type="checkbox"/> 16 Other (specify below)
2 Sewer lines	7 Pit privy	12 Fertilizer storage	<u>HOUSS</u>
3 Watertight sewer lines	8 Sewage lagoon	13 Insecticide storage	
4 Lateral lines	9 Feedyard	14 Abandoned water well	
5 Cess Pool	10 Livestock pens	15 Oil well/Gas well	

Direction from well? WEST How many feet? 75

FROM	TO	PLUGGING MATERIALS
<u>0</u>	<u>75</u>	<u>BENTONITE (9.28 SF³)</u>

7 CONTRACTOR'S OR LANDOWNER'S CERTIFICATION: This water well was plugged under my jurisdiction and was completed on (mo/day/year) 11/18/01 and this record is true to the best of my knowledge and belief. Kansas Water Well Contractor's License No. 585 This Water Well Record was completed on (mo/day/year) 11/19/01 under the business name of ASSOCIATED ENVIRONMENTAL PAK by (signature) [Signature]

INSTRUCTIONS: Use typewriter or ball point pen. Please press firmly and print clearly. Please fill in blanks, underline or circle the correct answers. Send top three copies to Kansas Department of Health and Environment, Bureau of Water, Topeka, Kansas 66620-0001. Telephone: 785/296-3565. Send one to Water Well Owner and retain one for your records.