


WU465

1 LOCATION OF WATER WELL: Fraction SW 1/4 SW 1/4 NR 1/4 Section Number 29 Township Number T 7 S Range Number R 6 EW
 County: RILEY

Distance and direction from nearest town or city street address of well if located within city?
FROM RANDOLPH: 3/4 MILE WEST 3/4

2 WATER WELL OWNER: CAROL WILKROD
 RR#, St. Address, Box # : 12101 ALABAMA RD. Board of Agriculture, Division of Water Resources
 City, State, ZIP Code : LEONARDVILLE, KS. 66449 Application Number: _____

3 LOCATE WELL'S LOCATION WITH AN "X" IN SECTION BOX: 4 DEPTH OF COMPLETED WELL 140 ft. ELEVATION: _____

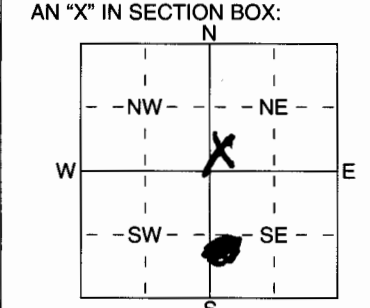

Depth(s) Groundwater Encountered 1 75 ft. 2 _____ ft. 3 _____ ft.
 WELL'S STATIC WATER LEVEL 69 ft. below land surface measured on mo/day/yr 11/17/04
 Pump test data: Well water was _____ ft. after _____ hours pumping _____ gpm
 Est. Yield 4 gpm: Well water was _____ ft. after _____ hours pumping _____ gpm
 WELL WATER TO BE USED AS: 5 Public water supply 8 Air conditioning 11 Injection well
 1 Domestic 3 Feedlot 6 Oil field water supply 9 Dewatering 12 Other (Specify below)
 2 Irrigation 4 Industrial 7 Domestic (lawn & garden) 10 Monitoring well

Was a chemical/bacteriological sample submitted to Department? Yes _____ No X; If yes, mo/day/yr sample was submitted
 Water Well Disinfected? Yes X No _____

5 TYPE OF BLANK CASING USED: 5 Wrought iron 8 Concrete tile CASING JOINTS: Glued X Clamped _____
 1 Steel 3 RMP (SR) 6 Asbestos-Cement 9 Other (specify below) Welded _____
 2 PVC 4 ABS 7 Fiberglass Threaded _____

Blank casing diameter 5 in. to 140 ft., Dia _____ in. to _____ ft., Dia _____ in. to _____ ft.
 Casing height above land surface 24 in., weight _____ lbs./ft. Wall thickness or guage No. SAR21

TYPE OF SCREEN OR PERFORATION MATERIAL: 10 Asbestos-Cement
 1 Steel 3 Stainless Steel 5 Fiberglass 8 RMP (SR) 11 Other (Specify) _____
 2 Brass 4 Galvanized Steel 6 Concrete tile 9 ABS 12 None used (open hole)

SCREEN OR PERFORATION OPENINGS ARE: 5 Gauzed wrapped 8 Saw cut 11 None (open hole)
 1 Continuous slot 3 Mill slot 6 Wire wrapped 9 Drilled holes
 2 Louvered shutter 4 Key punched 7 Torch cut 10 Other (specify) _____ ft.

SCREEN-PERFORATED INTERVALS: From 120 ft. to 140 ft., From _____ ft. to _____ ft.
 From _____ ft. to _____ ft., From _____ ft. to _____ ft.
 GRAVEL PACK INTERVALS: From 25 ft. to 140 ft., From _____ ft. to _____ ft.
 From _____ ft. to _____ ft., From _____ ft. to _____ ft.

6 GROUT MATERIAL: 1 Neat cement 2 Cement grout 3 Bentonite 4 Other _____
 Grout Intervals: From 3 ft. to 25 ft., From _____ ft. to _____ ft., From _____ ft. to _____ ft.

What is the nearest source of possible contamination:
 1 Septic tank 4 Lateral lines 7 Pit privy 10 Livestock pens 14 Abandoned water well
 2 Sewer lines 5 Cess pool 8 Sewage lagoon 11 Fuel storage 15 Oil well/Gas well
 3 Watertight sewer lines 6 Seepage pit 9 Feedyard 12 Fertilizer storage 16 Other (specify below) OPEN PIT
 9 Feedyard 13 Insecticide storage
 Direction from well? _____ How many feet? _____

FROM	TO	LITHOLOGIC LOG	FROM	TO	PLUGGING INTERVALS
0	6	CLAY BROWN			
6	15	LIMESTONE TAN			
15	22	SHALE TAN			
22	24	LIMESTONE TAN			
24	64	SAND TAN TO RED			
64	75	SAND LOOSE H ₂ O			
75	85	SAND GRAY			
85	88	LIMESTONE			
88	140	SAND GRAY			
	140	TOTAL DEPTH			

7 CONTRACTOR'S OR LANDOWNER'S CERTIFICATION: This water well was (1) constructed, (2) reconstructed, or (3) plugged under my jurisdiction and was completed on (mo/day/year) 11/17/04 and this record is true to the best of my knowledge and belief. Kansas Water Well Contractor's Licence No 505 This Water Well Record was completed on (mo/day/yr) 11/23/04 under the business name of ASSOCIATED PANHANDLE PUMP & SERVICE INC by (signature) _____