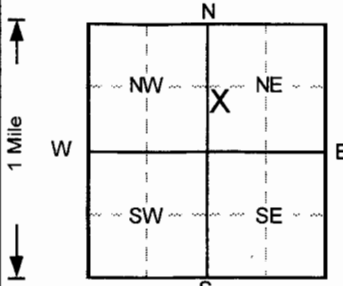


1 LOCATION OF WATER WELL: County: Riley	Fraction NW ¼ SW ¼ NE ¼	Section Number 28	Township Number T 7 S	Range Number R 6 E/W
---	-----------------------------------	-----------------------------	---------------------------------	--------------------------------

Distance and direction from nearest town or city street address of well if located within city?
13700 Tuttle Creek Blvd., Randolph

2 WATER WELL OWNER: **Leiszler Oil Company**
 RR#, St. Address, Box # : **635 W. Crawford** Board of Agriculture, Division of Water Resources
 City, State, ZIP Code : **Clay Center, Kansas 67432** Application Number:

3 LOCATE WELL'S LOCATION WITH AN "X" IN SECTION BOX: 	4 DEPTH OF COMPLETED WELL 82 ft ELEVATION: 1294.3 Depth(s) Groundwater Encountered 1. ft. 2. ft. 3. ft. WELL'S STATIC WATER LEVEL 72 ft. below land surface measured on mo/day/yr 11/8/2007 Pump test data: Well water was NA ft. after hours pumping gpm Est. Yield NA gpm: Well water was ft. after hours pumping gpm Bore Hole Diameter 6 in. to 82 ft. and in. to ft. WELL WATER TO BE USED AS: 5 Public water supply 8 Air conditioning 11 Injection well 1 Domestic 3 Feedlot 6 Oil field water supply 9 Dewatering 12 Other (Specify below) 2 Irrigation 4 Industrial 7 Lawn and garden only 10 Monitoring well Was a chemical/bacteriological sample submitted to Department? Yes No <input checked="" type="checkbox"/> ; If yes, mo/day/yr sample was submitted Water Well Disinfected? Yes No <input checked="" type="checkbox"/>
---	---

5 TYPE OF BLANK CASING USED: 1 Steel 3 RMP (SR) 5 Wrought iron 8 Concrete tile CASING JOINTS: Glued Clamped
 2 PVC 4 ABS 6 Asbestos-Cement 9 Other (specify below) Welded
 7 Fiberglass Threaded.

Blank casing diameter **2** in. to **62** ft. Dia in. to ft. Dia in. to ft.
 Casing height above land surface **26.28** in., weight lbs./ft. Wall thickness or gauge No. **Sch. 40**

TYPE OF SCREEN OR PERFORATION MATERIAL 7 PVC 10 Asbestos-cement
 1 Steel 3 Stainless steel 5 Fiberglass 8 RMP (SR) 11 Other (specify)
 2 Brass 4 Galvanized steel 6 Concrete tile 9 ABS 12 None used (open hole)

SCREEN OR PERFORATION OPENINGS ARE: 3 Mill slot 5 Gauzed wrapped 8 Saw cut 11 None (open hole)
 1 Continuous slot 6 Wire wrapped 9 Drilled holes
 2 Louvered shutter 4 Key punched 7 Torch cut 10 Other (specify)

SCREEN-PERFORATED INTERVALS: From **62** ft. to **82** ft. From ft. to ft.
 From ft. to ft. From ft. to ft.
 GRAVEL PACK INTERVALS: From **59** ft. to **82** ft. From ft. to ft.
 From ft. to ft. From ft. to ft.

6 GROUT MATERIAL: 1 Neat cement 2 Cement grout 3 Bentonite 4 Other
 Grout Intervals: From **0** ft. to **2** ft. From **2** ft. to **59** ft. From ft. to ft.

What is the nearest source of possible contamination:
 1 Septic tank 4 Lateral lines 7 Pit privy 10 Livestock pens 14 Abandoned water well
 2 Sewer lines 5 Cess pool 8 Sewage lagoon 11 Fuel storage 15 Oil well/Gas well
 3 Watertight sewer lines 6 Seepage pit 9 Feedyard 12 Fertilizer storage 16 Other (specify below)
 13 Insecticide storage
 Direction from well? How many feet?

FROM	TO	LITHOLOGIC LOG	FROM	TO	PLUGGING INTERVALS
0	3	Clay, silty, moist, Brown	66	73	Shale, sl. moist, poss. sl. odor, Yellow-Brown
3	4	Shale, v. weathered, Yellow-Brown	73	76	Shale, moist, sl. odor, Lt. Yellow-Brown
4	6	Limestone, v. argillaceous, hard, Yellow	76	78	Limestone, hard, Gray
6	10	Limestone, v. hard, Lt. Gray	78	79	Shale, sl. odor, Yellow-Brown
10	21	Shale, sl. silty, firm, no odor, Yellow-Brown	79	82	Limestone, saturated, no odor, Gray
21	23	Shale, firm, no odor, Gray			
23	25	Limestone, hard, Lt. Gray			
25	36	Shale, dry, firm, no odor, Gray-Green			
36	38	Shale, dry, no odor,			
38	39	Shale, no odor, Gray-Green			
39	50	Shale, Red, alt. w/Green			
50	55	Shale, dry, no odor, Lt. Green			
55	56	Shale, dry, no odor, Lt. Red			MW3, Tag # 0041725, Abovegrade
56	64	Shale, dry, firm, Lt. Green			Project Name: L K 66 "Braddocks"
64	66	Shale, sl. moist, no odor, Gray-Green			GeoCore # 1361, KDHE # U5 081 12275

7 CONTRACTOR'S OR LANDOWNER'S CERTIFICATION: This water well was **(1)** constructed, (2) reconstructed, or (3) plugged under my jurisdiction and was completed on (mo/day/year) **11/6/2007** and this record is true to the best of my knowledge and belief.
 Kansas Water Well Contractor's License No. **527** This Water Well Record was completed on (mo/day/yr) **11/14/2007** under the business name of **GeoCore, Inc.** by (signature) *Debra Bell*

OFFICE USE ONLY

T

R

EW

SEC.

¼

¼

¼