


1 LOCATION OF WATER WELL:	Fraction	Section Number	Township Number	Range Number
County: Riley	NW 1/4 SW 1/4 NE 1/4	28	T 7 S	R 6 E/W

Distance and direction from nearest town or city street address of well if located within city?
13700 Tuttle Creek Blvd., Randolph

2 WATER WELL OWNER: **Leiszler Oil Company**
 RR#, St. Address, Box # : **635 W. Crawford**
 City, State, ZIP Code : **Clay Center, Kansas 67432**
 Board of Agriculture, Division of Water Resources
 Application Number:

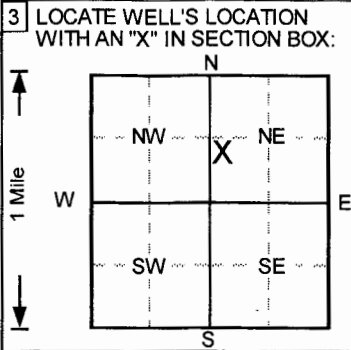

4 DEPTH OF COMPLETED WELL: **74** ft. ELEVATION: **1287.74**
 Depth(s) Groundwater Encountered 1. ft. 2. ft. 3. ft.
 WELL'S STATIC WATER LEVEL: **62.87** ft. below land surface measured on mo/day/yr **11/8/2007**
 Pump test data: Well water was **NA** ft. after hours pumping gpm
 Est. Yield **NA** gpm: Well water was ft. after hours pumping gpm
 Bore Hole Diameter **6** in. to **74** ft., and in. to ft.
 WELL WATER TO BE USED AS:
 5 Public water supply 8 Air conditioning 11 Injection well
 1 Domestic 3 Feedlot 6 Oil field water supply 9 Dewatering 12 Other (Specify below)
 2 Irrigation 4 Industrial 7 Lawn and garden only **10 Monitoring well**
 Was a chemical/bacteriological sample submitted to Department? Yes.....No ; If yes, mo/day/yr sample was submitted
 Water Well Disinfected? Yes No

5 TYPE OF BLANK CASING USED:
 1 Steel 3 RMP (SR) 5 Wrought iron 8 Concrete tile CASING JOINTS: Glued Clamped
2 PVC 4 ABS 6 Asbestos-Cement 9 Other (specify below) Welded
 7 Fiberglass Threaded.
 Blank casing diameter **2** in. to **54** ft., Dia in. to ft., Dia in. to ft.
 Casing height above land surface **-1.68** in., weight lbs./ft. Wall thickness or gauge No. **Sch. 40**
 TYPE OF SCREEN OR PERFORATION MATERIAL
 1 Steel 3 Stainless steel 5 Fiberglass **7 PVC** 10 Asbestos-cement
 2 Brass 4 Galvanized steel 6 Concrete tile 8 RMP (SR) 11 Other (specify)
 9 ABS 12 None used (open hole)
 SCREEN OR PERFORATION OPENINGS ARE:
 1 Continuous slot **3 Mill slot** 5 Gauzed wrapped 8 Saw cut 11 None (open hole)
 2 Louvered shutter 4 Key punched 6 Wire wrapped 9 Drilled holes
 7 Torch cut 10 Other (specify)
 SCREEN-PERFORATED INTERVALS: From **54** ft. to **74** ft., From ft. to ft.
 From ft. to ft., From ft. to ft.
 GRAVEL PACK INTERVALS: From **51** ft. to **74** ft., From ft. to ft.
 From ft. to ft., From ft. to ft.

6 GROUT MATERIAL: 1 Neat cement **2 Cement grout** **3 Bentonite** 4 Other
 Grout Intervals: From **0** ft. to **1** ft., From **1** ft. to **51** ft., From ft. to ft.
 What is the nearest source of possible contamination:
 1 Septic tank 4 Lateral lines 7 Pit privy 10 Livestock pens 14 Abandoned water well
 2 Sewer lines 5 Cess pool 8 Sewage lagoon 11 Fuel storage 15 Oil well/Gas well
 3 Watertight sewer lines 6 Seepage pit 9 Feedyard 12 Fertilizer storage 16 Other (specify below)
 13 Insecticide storage
 Direction from well? How many feet?

FROM	TO	LITHOLOGIC LOG	FROM	TO	PLUGGING INTERVALS
0	1	Clay, moist, no odor, Brown to Yellow-Brown	72	74	Shale, no odor, Yellow Brown
1	4	Limestone, hard, Gray			
4	12	Shale, dry, firm, no odor, Yellow to Yellow-Br			
12	13.5	Limestone, hard, Lt. Gray			
13.5	17	Shale, dry, firm, no odor, Yellow-Brown			
17	26	Shale, dry, firm, no odor, Lt. Green to Gray-G			
26	29	Shale, silty, firm, no odor, Red-Brown			
29	31	Shale, dry, no odor, Gray-Green			
31	50	Shale, firm, no odor, Red-Brown w/alt. Green			
50	57	Shale, dry, 2" limestone @ 54', Lt. Green			
57	59	Shale, no odor, Gray-Green			
59	66	Shale, moist, no odor, Yellow to Yellow-Brow			
66	67	Limestone, hard, wet, Lt. Gray			MW4, Tag # 0041728, Flushmount
67	68	Shale, no odor, Yellow-Brown			Project Name: L K 66 "Braddocks"
68	72	Limestone, hard, wet, Gray			GeoCore # 1361, KDHE # U5 081 12275

CORRECTED

7 CONTRACTOR'S OR LANDOWNER'S CERTIFICATION: This water well was **(1)** constructed, (2) reconstructed, or (3) plugged under my jurisdiction and was completed on (mo/day/year) **11/7/2007** and this record is true to the best of my knowledge and belief.
 Kansas Water Well Contractor's License No. **527** This Water Well Record was completed on (mo/day/yr) **11/14/2007** under the business name of **GeoCore, Inc.** by (signature) *Doc Kelly*

OFFICE USE ONLY
 T
 R
 EW
 SEC.
 1/4
 1/4
 1/4