


1 LOCATION OF WATER WELL: County: <u>Riley</u>	Fraction <u>SE 1/4 NW 1/4 NW 1/4</u>	Section Number <u>18</u>	Township Number <u>7</u>	Range Number <u>6</u>
---	---	-----------------------------	-----------------------------	--------------------------

Distance and direction from nearest town or city street address of well if located within city?

2 WATER WELL OWNER: <u>Wietor Family LLC, c/o Gary Hogener</u> <u>15313 Wietor Rd</u> RR #, St. Address, Box #: <u>Randolph KS 66554</u> City, State, ZIP Code :	Board of Agriculture, Division of Water Resources Application Number:
---	--

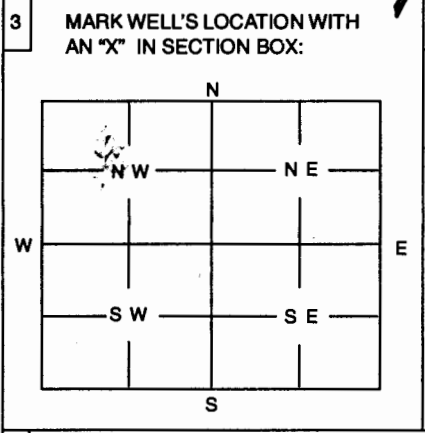

4 DEPTH OF WELL 34 ft

WELL'S STATIC WATER LEVEL ft.

WELL WAS USED AS:

1 Domestic	5 Public Water Supply	9 Dewatering
2 Irrigation	6 Oil Field Water Supply	10 Monitoring Well
3 Feedlot	<input checked="" type="checkbox"/> 7 Domestic (Lawn & Garden)	11 Injection Well
4 Industrial	8 Air Conditioning	12 Other <u>Watering Livestock</u>

Was a chemical / bacteriological sample submitted to Department? Yes No

If yes, mo/day/yr sample was submitted

Water Well Disinfected: Yes No

5 TYPE OF BLANK CASING USED:

Steel 3 RMP (SR) 5 Wrought 7 Fiberglass 9 Other (Specify below)

2 PVC 4 ABS 6 Asbestos-Cement 8 Concrete Tile

Blank casing diameter 6 in. Was casing pulled? Yes No

Casing height above or below land surface 4 ft in. If yes, how much 4 ft

6 GROUT PLUG MATERIAL: 1 Neat cement 2 Cement grout 3 Bentonite 4 Other

Grout Plug Intervals: From 34 ft. to 20 ft., From 20 ft. to 7 ft., From 7 to 4 ft.

What is the nearest source of possible contamination:

1 Septic tank	6 Seepage pit	11 Fuel storage	16 Other (specify below)
2 Sewer lines	7 Pit privy	12 Fertilizer storage	
3 Watertight sewer lines	8 Sewage lagoon	13 Insecticide storage	
4 Lateral lines	9 Feedyard	<input checked="" type="radio"/> 14 Abandoned water well	
5 Cess Pool	10 Livestock pens	15 Oil well/Gas well	

Direction from well? How many feet?

FROM	TO	PLUGGING MATERIALS
<u>34</u>	<u>20</u>	<u>Sand</u>
<u>20</u>	<u>7</u>	<u>Lime stone</u>
<u>7</u>	<u>4</u>	<u>Bentonite</u>
<u>4</u>	<u>Ground</u>	<u>Fill Black Dirt</u>

7 CONTRACTOR'S OR LANDOWNER'S CERTIFICATION: This water well was plugged under my jurisdiction and was completed on (mo/day/year) and this record is true to the best of my knowledge and belief. Kansas Water Well Contractor's License No. 7-25-08 under the business name of Wietor Family LLC This Water Well Record was completed on (mo/day/year) by (signature) Helen Wietor

INSTRUCTIONS: Use typewriter or ball point pen. Please press firmly and print clearly. Please fill in blanks, underline or circle the correct answers. Send top three copies to Kansas Department of Health and Environment, Bureau of Water, Topeka, Kansas 66620-0001. Telephone: 785/296-3565. Send one to Water Well Owner and retain one for your records.