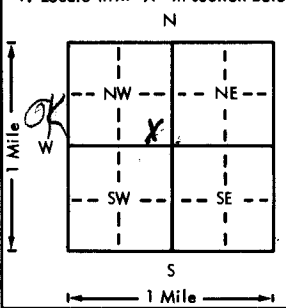


USE TYPEWRITER OR BALL POINT PEN-PRESS FIRMLY, PRINT CLEARLY.

WATER WELL RECORD
KSA 82a-1201-1215

Kansas Department of Health and Environment-Division of Environment
(Water well Contractors)
Topeka, Kansas 66620

NE SW NW

1. Location of well: County: Riley		Fraction: SE 1/4 SE 1/4 NW 1/4		Section number: 3	Township number: T 7 S	Range number: R 6 E
2. Distance and direction from nearest town or city: 3 1/2 M. N E of Randolph KS Street address of well location if in city:				3. Owner of well: Paul Rasmussen R.R. location City, state, zip code: Randolph KS 66554		
4. Locate with "X" in section below: 				Sketch map: first mail box N. of bridge on E. side 1st Rd after bridge Tuttle Creek Res Sat Mail		
5. Type and color of material				6. Bore hole dia. 10 in. Completion date 6-24-77 Well depth 50 ft.		
				7. <input checked="" type="checkbox"/> Cable tool <input type="checkbox"/> Rotary <input type="checkbox"/> Driven <input type="checkbox"/> Dug <input type="checkbox"/> Hollow rod <input type="checkbox"/> Jetted <input type="checkbox"/> Bored <input type="checkbox"/> Reverse rotary		
				8. Use: <input type="checkbox"/> Domestic <input type="checkbox"/> Public supply <input type="checkbox"/> Industry <input type="checkbox"/> Irrigation <input type="checkbox"/> Air conditioning <input checked="" type="checkbox"/> Stock <input type="checkbox"/> Lawn <input type="checkbox"/> Oil field water <input type="checkbox"/> Other		
				9. Casing: Material Plst Height: Above or Below surface Threaded <input type="checkbox"/> Welded Chic Surface 60 in. RMP <input type="checkbox"/> PVC <input checked="" type="checkbox"/> Weight 60 lbs./ft. Dia. 5 in. to 50 ft. depth Wall Thickness: 3/8 inches or Dia. 5 in. to 50 ft. depth Gage No. Sen 70		
				10. Screen: Manufacturer's name Pumpco Type PVC Dia. 5" Slot/gauze #20 Length 30' Set between 50 ft. and 50 ft. Gravel pack? Yes Size range of material 1/4 - 1/2		
				11. Static water level: 20 ft. below land surface Date 6-24-77 mo./day/yr.		
				12. Pumping level below land surfaces: ____ ft. after ____ hrs. pumping ____ g.p.m. ____ ft. after ____ hrs. pumping ____ g.p.m. Estimated maximum yield ____ g.p.m.		
				13. Water sample submitted: ____ mo./day/yr. Yes <input checked="" type="checkbox"/> No <input type="checkbox"/> Date		
				14. Well head completion: ____ Pitless adapter ____ Inches above grade		
				15. Well grouted? Yes With: <input checked="" type="checkbox"/> Neat cement <input type="checkbox"/> Bentonite <input type="checkbox"/> Concrete Depth: From 5 ft. to 15 ft.		
				16. Nearest source of possible contamination: ft. 5 Direction W Type Creek Well disinfected upon completion? <input checked="" type="checkbox"/> Yes <input type="checkbox"/> No		
				17. Pump: ____ Not installed Manufacturer's name ____ Model number ____ HP ____ Volts ____ Length of drop pipe ____ ft. capacity ____ g.p.m. Type: <input type="checkbox"/> Submersible <input type="checkbox"/> Turbine <input type="checkbox"/> Jet <input type="checkbox"/> Reciprocating <input type="checkbox"/> Centrifugal <input type="checkbox"/> Other		
18. Elevation: 1160		19. Remarks: Cement slab to be poured by land owner Paul Rasmussen		20. Water well contractor's certification: This well was drilled under my jurisdiction and this report is true to the best of my knowledge and belief. Hesperus Drilling Serv. 1766 Business name Blue Rapids KS License No. 6-24-77 Address 6-24-77 Signed Ed E. Hesperus Date 6-24-77 Authorized representative		

Forward the white, blue and pink copies to the Department of Health and Environment

Form WWC-5

Drilling Well permits Acquired By land owner
From Riley Co. Health Dept. Manhattan, KS.

T 7 S R 6 E S 3 SE 1/4 NW 1/4