USE TYPEWRITER OR BALL POINT PEN-PRESS FIRMLY, PRINT CLEARLY.

WATER WELL RECORD
KSA 82a-1201-1215

Kansas Department of Health and Environment-Division of Environment
(Water well Contractors)
Topeka, Kansas 66620

1. Location of well:	County	Fraction	Section number	Township number	Range number
	Riley	SE 1/4 SW 1/4 SE 1/4	17	T 7 S	R 6 (E) W

2. Distance and direction from nearest town or city: 1/4 N. 1 1/2 W. of Randolph, Ks.
Street address of well location if in city:

3. Owner of well: Donald Area
R.R. or street: 2130 Gillman Drive
City, state, zip code: Manhattan Kans.

4. Locate with "X" in section below:

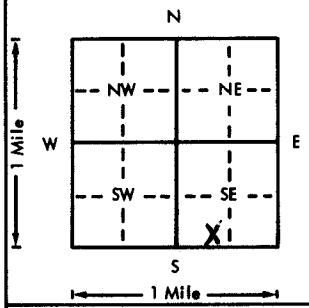

Sketch map:

6. Bore hole dia. 8 in. Completion date
Well depth 115 ft. 2-23-76

7. X Cable tool __ Rotary __ Driven __ Dug
__ Hollow rod __ Jetted __ Bored __ Reverse rotary

8. Use: __ Domestic __ Public supply __ Industry
__ Irrigation __ Air conditioning X Stock
__ Lawn __ Oil field water __ Other

9. Casing: Material PLST Height: (Above) or below
Threaded __ Welded B1 Surface 18 in.
RMP X PVC __ Weight __ lbs./ft.
Dia. 5 in. to 115 ft. depth Wall Thickness: inches or
Dia. __ in. to __ ft. depth gage No. 200

10. Screen: Manufacturer's name Slotted By Driller
Type RMP Dia. 5"
(Slot) gauze 1/16 Length 20
Set between 60 ft. and 70 ft.
105 ft. and 115 ft.
Gravel pack? yes Size range of material 1/8 - 1/4

11. Static water level: mo./day/yr.
40 ft. below land surface Date 2-23-76

12. Pumping level below land surfaces:
__ ft. after __ hrs. pumping __ g.p.m.
__ ft. after __ hrs. pumping __ g.p.m.
Estimated maximum yield __ g.p.m.

13. Water sample submitted: mo./day/yr.
__ Yes X No Date

14. Well head completion:
X Pitless adapter 18 Inches above grade

15. Well grouted? Yes
With: X Neat cement __ Bentonite __ Concrete
Depth: From 4 ft. to 15 ft.

16. Nearest source of possible contamination:
ft. 500 Direction NW Type Gas Tanks
Well disinfected upon completion? X Yes __ No

17. Pump: X Not installed
Manufacturer's name
Model number HP Volts
Length of drop pipe ft. capacity g.p.m.
Type:
__ Submersible __ Turbine
__ Jet __ Reciprocating
__ Centrifugal __ Other

5. Type and color of material	From	To
Top Soil Black dirt	0	1
Yellow Clay With Gavel	1	3
" Lime Rock	3	15
Brown Clay	15	25
Blue Shale	25	35
Gray Lime Rock	35	45
White " "	45	55
Blue Shale	55	70
Blue flint + Lime Rock	70	75
Blue Shale	75	85
Blue flint + Lime Rock	85	95
" " + " "	95	100
Blue Shale	100	110
Brown "	110	115

(Use a second sheet if needed)

18. Elevation:
Topography:
__ Hill
__ Slope
X Upland
__ Valley

19. Remarks:
Concrete Slab to be Installed By owner His agreement

20. Water well contractor's certification:
This well was drilled under my jurisdiction and this report is true to the best of my knowledge and belief.
Business name Service
Address Blue Rapids License No. 176
Signed Authorized representative Date 2-23-76

T 7 R 6 (E) W Sec 17 1/4 1/4 1/4 SE SE SE

Forward the white, blue and pink copies to the Department of Health and Environment

Form WWC-5

M1-1083