USE TYPEWRITER OR BALL POINT PEN-PRESS FIRMLY, PRINT CLEARLY.

WATER WELL RECORD
KSA 82a-1201-1215

Kansas Department of Health and Environment-Division of Environment
(Water well Contractors)
Topeka, Kansas 66620

1. Location of well:	County	Fraction	Section number	Township number	Range number
	Riley	SE 1/4 SE 1/4 SE 1/4	18	T - [redacted] - 7 - S	R - 6 - [redacted] E W

2. Distance and direction from nearest town or city: ½ N. 1½ W. of Randolph, Ks.
Street address of well location if in city:

3. Owner of well: Eldon Hargrave
R.R. ~~or street~~:
City, state, zip code: Randolph Kans. 66554

4. Locate with "X" in section below:

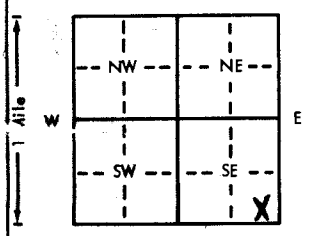

Sketch map: Clean Out + Ream Hole

6. Bore hole dia. 8 in. Completion date
Well depth 42 ft. 1-14-77

7. X Cable tool __ Rotary __ Driven __ Dug
__ Hollow rod __ Jetted __ Bored __ Reverse rotary

8. Use: __ Domestic __ Public supply __ Industry
__ Irrigation __ Air conditioning X Stock
__ Lawn __ Oil field water __ Other

9. Casing: Material Plst. Height: Above ~~or below~~
Threaded __ Welded Glue Surface 14 in.
RMP X PVC __ Weight __ lbs./ft.
Dia. 5 in. to 42 ft. depth Wall Thickness: inches or
Dia. __ in. to __ ft. depth gage No. 200

5. Type and color of material	From	To
Clay Brown	0	10
Lime Rock White	10	15
Clay Yellow	15	30
Lime Rock with Flint Blue	30	40
" " " " "	40	42

10. Screen: Manufacturer's name Slot By Driller
Type RMP Dia. 5"
Slot/gauze 16 Length 14
Set between 28 ft. and 42 ft.
ft. and ft.
Gravel pack? Yes Size range of material ¼-½

11. Static water level: mo./day/yr.
20 ft. below land surface Date 2-14-77

12. Pumping level below land surfaces:
ft. after hrs. pumping g.p.m.
ft. after hrs. pumping g.p.m.
Estimated maximum yield g.p.m.

13. Water sample submitted: mo./day/yr.
__ Yes X No Date

14. Well head completion:
__ Pitless adapter ____ Inches above grade

15. Well grouted? Yes
With: X Neat cement __ Bentonite __ Concrete
Depth: From 4 ft. to 14 ft.

16. Nearest source of possible contamination:
ft. 500' Direction Any Type Stock
Well disinfected upon completion? X Yes __ No

17. Pump: X Not installed
Manufacturer's name
Model number HP Volts
Length of drop pipe ft. capacity g.p.m.
Type:
__ Submersible __ Turbine
__ Jet __ Reciprocating
__ Centrifugal __ Other

(Use a second sheet if needed)

18. Elevation:

Topography:
__ Hill
X Slope
__ Upland
__ Valley

19. Remarks: Cement to be Poured by land owner 4'x4'x4"-thick

20. Water well contractor's certification:
This well was drilled under my jurisdiction and this report is true to the best of my knowledge and belief.
Business name Harpers Drlg. Service License No.
Address Blue Rapids, Ks. 176
Signed C. E. Harper Date 1-14-77
Authorized representative

T 7 R 6 E Sec 18 1/4 1/4 1/4 SE SE SE

Forward the white, blue and pink copies to the Department of Health and Environment

Form WWC-5

MI-1023