


1 LOCATION OF WATER WELL: Fraction SE 1/4 NE 1/4 SE 1/4 Section Number 22 Township Number T 7 S Range Number R 6 EW
 County: Riley
 Distance and direction from nearest town or city street address of well if located within city? From Randolph Co 1 mile East
1/2 mile South

2 WATER WELL OWNER: Mabel Bardeleben
 RR#, St. Address, Box #: 2046 Woodland
 City, State, ZIP Code: Wichita, KS 67203
 Board of Agriculture, Division of Water Resources
 Application Number:

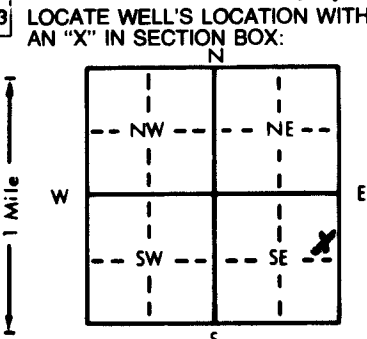

4 DEPTH OF COMPLETED WELL: 180' ft. ELEVATION: ft.
 Depth(s) Groundwater Encountered 1. 123 ft. 2. ft. 3. ft.
 WELL'S STATIC WATER LEVEL: 119 ft. below land surface measured on mo/day/yr
 Pump test data: Well water was ft. after hours pumping gpm
 Est. Yield: 4.5 gpm; Well water was ft. after hours pumping gpm
 Bore Hole Diameter: 9 in. to 180' ft., and in. to ft.
 WELL WATER TO BE USED AS:
 1 Domestic 3 Feedlot 6 Oil field water supply 9 Dewatering 12 Other (Specify below)
 2 Irrigation 4 Industrial 7 Lawn and garden only 10 Monitoring well
 Was a chemical/bacteriological sample submitted to Department? Yes.....No.....; If yes, mo/day/yr sample was submitted
 Water Well Disinfected? Yes No

5 TYPE OF BLANK CASING USED:
 1 Steel 3 RMP (SR) 5 Wrought iron 8 Concrete tile CASING JOINTS: Glued Clamped
 2 PVC 4 ABS 6 Asbestos-Cement 9 Other (specify below) Welded Screwed
 7 Fiberglass Threaded
 Blank casing diameter: 5 in. to 160 ft., Dia. in. to ft., Dia. in. to ft.
 Casing height above land surface: 2 in., weight 54.40 lbs./ft. Wall thickness or gauge No.
 TYPE OF SCREEN OR PERFORATION MATERIAL:
 1 Steel 3 Stainless steel 5 Fiberglass 8 RMP (SR) 11 Other (specify)
 2 Brass 4 Galvanized steel 6 Concrete tile 9 ABS 12 None used (open hole)
 SCREEN OR PERFORATION OPENINGS ARE:
 1 Continuous slot 3 Mill slot 3/3000's 5 Gauzed wrapped 8 Saw cut 11 None (open hole)
 2 Louvered shutter 4 Key punched 6 Wire wrapped 9 Drilled holes
 7 Torch cut 10 Other (specify)
 SCREEN-PERFORATED INTERVALS: From 160 ft. to 180 ft., From ft. to ft.
 From ft. to ft., From ft. to ft.
 GRAVEL PACK INTERVALS: From 20 ft. to 180 ft., From ft. to ft.
 From ft. to ft., From ft. to ft.

6 GROUT MATERIAL: 1 Neat cement 2 Cement grout 3 Bentonite 4 Other
 Grout Intervals: From 0 ft. to 20 ft., From ft. to Envirapack ft. to ft. to ft.
 What is the nearest source of possible contamination:
 1 Septic tank 4 Lateral line 7 Pit privy 10 Livestock pens 14 Abandoned water well
 2 Sewer lines 5 Cess pool 8 Sewage lagoon 11 Fuel storage 15 Oil well/Gas well
 3 Watertight sewer lines 6 Seepage pit 9 Feedyard 12 Fertilizer storage 16 Other (specify below)
 13 Insecticide storage
 Direction from well? 100' How many feet? South East

FROM	TO	LITHOLOGIC LOG	FROM	TO	PLUGGING INTERVALS
0	11	Brown clay	151	165	Limestone
11	13	Limestone	165	180	Grey shale
13	24	Brown shale			
24	31	Limestone			
31	42	Yellow shale			
42	44	Limestone			
44	49	Greenish shale			
49	67	Limestone			
67	74	Grey shale			
74	77	Limestone			
77	85	Grey shale			
85	113	Limestone			
113	123	Grey shale			
123	124	Limestone			
124	151	Brown shale			

7 CONTRACTOR'S OR LANDOWNER'S CERTIFICATION: This water well was (1) constructed, (2) reconstructed, or (3) plugged under my jurisdiction and was completed on (mo/day/year) 8/18/90 and this record is true to the best of my knowledge and belief. Kansas Water Well Contractor's License No. 451 This Water Well Record was completed on (mo/day/yr) 9/3/90 under the business name of Holdeman Well Drilling by (signature) Craig C. W. PE

OFFICE USE ONLY
T
R
EW
SEC.
1/4
1/4
1/4