


1 LOCATION OF WATER WELL: Fraction Section Number Township Number Range Number  
 County: RILEY NW 1/4 NE 1/4 NW 1/4 32 T 7 S R 6 E/W

Distance and direction from nearest town or city street address of well if located within city?  
 1 1/2 south, 1 west of Randolph

2 WATER WELL OWNER: Steve Hargrave  
 RR#, St. Address, Box # : 10051 Senn Road Board of Agriculture, Division of Water Resources  
 City, State, ZIP Code : Randolph, KS 66554 Application Number:

3 LOCATE WELL'S LOCATION WITH AN "X" IN SECTION BOX:

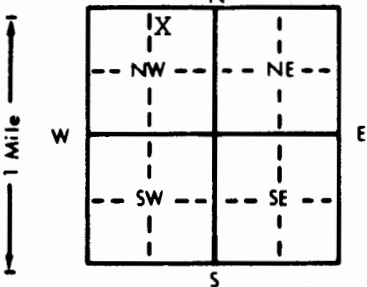

4 DEPTH OF COMPLETED WELL... 100' ft. ELEVATION: ...

Depth(s) Groundwater Encountered 1. 82' ft. 2. ft. 3. ft.  
 WELL'S STATIC WATER LEVEL... 52' ft. below land surface measured on mo/day/yr 2-17-92  
 Pump test data: Well water was ft. after hours pumping gpm  
 Est. Yield... 18 gpm: Well water was ft. after hours pumping gpm  
 Bore Hole Diameter... 8 3/4 in. to ft., and in. to ft.  
 WELL WATER TO BE USED AS: 5 Public water supply 8 Air conditioning 11 Injection well  
 1 Domestic 3 Feedlot 6 Oil field water supply 9 Dewatering 12 Other (Specify below)  
 2 Irrigation 4 Industrial 7 Lawn and garden only 10 Monitoring well  
 Was a chemical/bacteriological sample submitted to Department? Yes No X; If yes, mo/day/yr sample was submitted  
 Water Well Disinfected? Yes X No

5 TYPE OF BLANK CASING USED: 5 Wrought iron 8 Concrete tile CASING JOINTS: Glued X Clamped  
 1 Steel 3 RMP (SR) 6 Asbestos-Cement 9 Other (specify below) Welded  
 2 PVC 4 ABS 7 Fiberglass Threaded

Blank casing diameter... 5 in. to 0-70 ft., Dia in. to ft., Dia in. to ft.  
 Casing height above land surface... 24 in., weight 2.82 lbs./ft. Wall thickness or gauge No. 258

TYPE OF SCREEN OR PERFORATION MATERIAL: 7 PVC 10 Asbestos-cement  
 1 Steel 3 Stainless steel 5 Fiberglass 8 RMP (SR) 11 Other (specify)  
 2 Brass 4 Galvanized steel 6 Concrete tile 9 ABS 12 None used (open hole)

SCREEN OR PERFORATION OPENINGS ARE: 5 Gauzed wrapped 8 Saw cut 11 None (open hole)  
 1 Continuous slot 3 Mill slot 6 Wire wrapped 9 Drilled holes  
 2 Louvered shutter 4 Key punched 7 Torch cut 10 Other (specify)

SCREEN-PERFORATED INTERVALS: From 70 ft. to 100 ft. From ft. to ft.  
 From ft. to ft. From ft. to ft.  
 GRAVEL PACK INTERVALS: From 30 ft. to 100 ft. From ft. to ft.  
 From ft. to ft. From ft. to ft.

6 GROUT MATERIAL: 1 Neat cement 2 Cement grout 3 Bentonite 4 Other  
 Grout Intervals: From 30 ft. to 100 ft. From ft. to ft. From ft. to ft.

What is the nearest source of possible contamination:  
 1 Septic tank 4 Lateral lines 7 Pit privy 10 Livestock pens 14 Abandoned water well  
 2 Sewer lines 5 Cess pool 8 Sewage lagoon 11 Fuel storage 15 Oil well/Gas well  
 3 Watertight sewer lines 6 Seepage pit 9 Feedyard 12 Fertilizer storage 16 Other (specify below)  
 13 Insecticide storage  
 Direction from well? south How many feet? 25'

FROM	TO	LITHOLOGIC LOG	FROM	TO	PLUGGING INTERVALS
0	4	Limestone-Yellow	82	100	Shale-Grey
4	17	Shale-Yellow			
17	21	Limestone-Yellow			
21	31	Shale-Yellow			
31	33	Shale-Red			
33	34	Shale-Grey			
34	37	Shale-Red			
37	41	Shale-Yellow			
41	43	Shale-Red			
43	50	Shale-grey			
50	54	Shale-Red			
54	64	Shale-Yellow			
64	70	Limestone-Yellow			
70	72	Limestone-Grey			
72	82	Limestone-Yellow-Loose			

7 CONTRACTOR'S OR LANDOWNER'S CERTIFICATION: This water well was (1) constructed, (2) reconstructed, or (3) plugged under my jurisdiction and was completed on (mo/day/year) 2-17-92 and this record is true to the best of my knowledge and belief. Kansas Water Well Contractor's License No. 182 This Water Well Record was completed on (mo/day/yr) 3-12-92 under the business name of STRADER DRILLING CO., INC. by signature Dale Bakken

OFFICE USE ONLY  
T  
R  
EW  
SEC.