

CORRECTION(S) TO WATER WELL RECORD (WWC-5)

(to rectify lacking or incorrect information)

County: Pottawatomie

Location listed as:

Section-Township-Range: 23 - RTE - T75

Fraction ($\frac{1}{4}$ $\frac{1}{4}$ $\frac{1}{4}$): SW

Location changed to:

23 - 7S - 7E

SW SW NE

Other changes: Initial statements: _____

Changed to: _____

Comments: _____

verification method: well address, township name, current Holt address in Olsburg, city street map, and Olsburg 1:24,000 topo. map.

initials: DRD date: 10/12/2005

USE TYPEWRITER OR BALL POINT PEN-PRESS FIRMLY, PRINT CLEARLY.


WATER WELL RECORD
KSA 82a-1201-1215

T R EW sec 1/4 1/4 1/4 No.

Kansas State Dept. Of Health
(Water Well Contractors)
Forbes-Bldg. 740
Topeka, Kansas 66620

1 Location of well: County Pott. Township name Blue Valley Fraction S.W. Quarter Section number sec. 23 Town number R7E Range number T7S

Distance and direction from nearest town or city: _____
Street address of well location if in city: Olsburg Ks.
3 Owner of well: Dennis Holt & Keith Roffler
Address: Olsburg Kns.

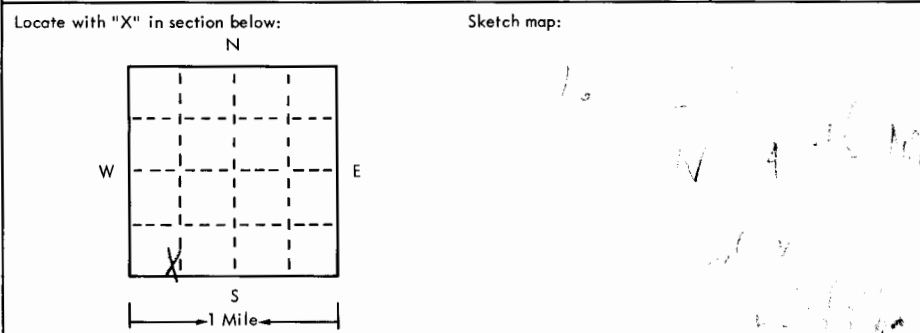

4 Well depth: 66 ft. Date of completion: 5/20/75
Well diameter 5 in.
5 Cable tool Rotary Driven Dug
 Hollow rod Jetted Bored Reverse rotary
6 Use: Domestic Public supply Industry
 Irrigation Air conditioning Commercial
 Test well _____
7 Casing: Material Steel Height: above/below
Threaded Welded Surface _____ in.
Diag. 7" Weight 24 lbs./ft. L
12 in. to 24 ft. depth Drive shoe? Yes No
27 in. to 64 ft. depth P.V.C. 5"

2	Type and color of material	From	To
	<u>Brown Clay</u>	<u>0</u>	<u>15</u>
	<u>Creek Gravel & Clay</u>	<u>15</u>	<u>20</u>
	<u>Glacer Sand & ROCKS</u>	<u>20</u>	<u>25</u>
	<u>Glacer Sand & 2' Lime Rock & 1st Water</u>	<u>25</u>	<u>30</u>
	<u>Brown Clay</u>	<u>30</u>	<u>35</u>
	<u>Brown Clay</u>	<u>35</u>	<u>45</u>
	<u>Lime & Flint Rock</u>	<u>45</u>	<u>50</u>
	<u>Lime Rock & Blue Shale & Soap Stone</u>	<u>50</u>	<u>55</u>
	<u>Lime Rock & Soap Stone</u>	<u>55</u>	<u>65</u>
	<u>Cherty Lime Rock</u>	<u>65</u>	<u>66</u>

8 Screen: Manufacturer Homade
Type Steel Dia. 5"
Slot/gauze Slot 1/4 Length 10'
Set between 19 ft. and 29 ft.
Fittings: Gravel pack Yes No Size range of material NO
9 Static water level: 19 ft. below land surface Date 5/20/75
10 Pumping level below land surfaces:
_____ ft. after N.A. h. pumping _____ g.p.m.
_____ ft. after N.A. min. pumping _____ g.p.m.
Estimated maximum yield _____ g.p.m.
11 Water sample submitted: Yes No Date May 20. 75
12 Well head completion: Pitless adapter N.A. Inches above grade
13 Well grouted? Yes No
 Neat cement Bentonite _____
Depth: From _____ ft. to _____ ft.
14 Nearest source of possible contamination: ft. 200 Direction either Type Farm
Well disinfected upon completion? Yes No
15 Pump: Not installed
Manufacturer's name _____
Model number _____ HP _____ Volts _____
Length of drop pipe _____ ft. capacity _____ g.m.p.
Type:
 Submersible Turbine
 Jet Reciprocating
 Centrifugal Other

16 Remarks: elevation 1145
Topography:
 Hill
 Slope
 Upland
 Valley

17 Water well contractor's certification:
This well was drilled under my jurisdiction and this report is true to the best of my knowledge and belief.
Harpers Drilg. Service
Business name _____ License No. _____
Address Blue Rapids Ks. 176
Signed C.E. Harpers Date 5-20-75
Authorized representative