

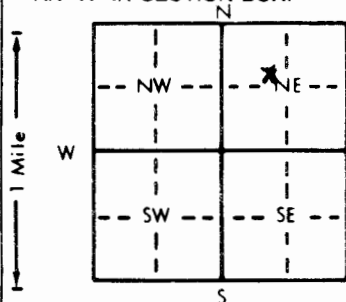
1 LOCATION OF WATER WELL:	Fraction	Section Number	Township Number	Range Number
County: <u>Pottawatomie</u>	<u>SE</u> $\frac{1}{4}$ NW $\frac{1}{4}$ NE $\frac{1}{4}$	<u>17</u>	T <u>07</u> S	R <u>07</u> E/W

Distance and direction from nearest town or city street address of well if located within city?

5 mile west & 2 mile North of Olsburg

2 WATER WELL OWNER:	RR#, St. Address, Box #	Board of Agriculture, Division of Water Resources
<u>Don Behrens</u>	<u>Rt 1</u>	
City, State, ZIP Code	<u>Olsburg, KS 66520</u>	Application Number:

3 LOCATE WELL'S LOCATION WITH AN "X" IN SECTION BOX:	4 DEPTH OF COMPLETED WELL	ft. ELEVATION:
--	---------------------------	----------------

Depth(s) Groundwater Encountered 1. 33 ft. 2. 29 ft. 3. 45 ft.WELL'S STATIC WATER LEVEL 29 ft. below land surface measured on mo/day/yr Jan 31 91Pump test data: Well water was 2.5 gpm. Well water was 28 ft. after 7 hours pumping 45 gpmEst. Yield 2.5 gpm. Well water was 28 ft. after 7 hours pumping 45 gpmBore Hole Diameter 8 5/8 in. to 28 ft. and 7 in. to 45 ft.

WELL WATER TO BE USED AS: 5 Public water supply 8 Air conditioning 11 Injection well

1 Domestic 3 Feedlot 6 Oil field water supply 9 Dewatering 12 Other (Specify below)

2 Irrigation 4 Industrial 7 Lawn and garden only 10 Monitoring well

Was a chemical/bacteriological sample submitted to Department? Yes X No X If yes, mo/day/yr sample was submittedWater Well Disinfected? Yes No

5 TYPE OF BLANK CASING USED:	5 Wrought iron	8 Concrete tile	CASING JOINTS: Glued <u>X</u> Clamped
------------------------------	----------------	-----------------	---------------------------------------

1 Steel 3 RMP (SR) 6 Asbestos-Cement 9 Other (specify below) Welded

2 PVC 4 ABS 7 Fiberglass Threaded

Blank casing diameter 5 in. to 29 ft. Dia 16 in. to 45 ft. Dia 16 in. to 45 ft.Casing height above land surface 16 in. weight 16 lbs./ft. Wall thickness or gauge No. SDR-26

TYPE OF SCREEN OR PERFORATION MATERIAL: 7 PVC 10 Asbestos-cement

1 Steel 3 Stainless steel 5 Fiberglass 8 RMP (SR) 11 Other (specify)

2 Brass 4 Galvanized steel 6 Concrete tile 9 ABS 12 None used (open hole)

SCREEN OR PERFORATION OPENINGS ARE: 5 Gauzed wrapped 8 Saw cut 11 None (open hole)

1 Continuous slot 3 Mill slot 6 Wire wrapped 9 Drilled holes

2 Louvered shutter 4 Key punched 7 Torch cut 10 Other (specify)

SCREEN-PERFORATED INTERVALS: From 29 ft. to 45 ft. From 29 ft. to 45 ft.GRAVEL PACK INTERVALS: From NONE ft. to NONE ft. From NONE ft. to NONE ft.

7 CONTRACTOR'S OR LANDOWNER'S CERTIFICATION: This water well was (1) constructed, (2) reconstructed, or (3) plugged under my jurisdiction and was

completed on (mo/day/year) Jan 31 - 91 and this record is true to the best of my knowledge and belief. KansasWater Well Contractor's License No. 218 This Water Well Record was completed on (mo/day/yr) Feb 12 - 91under the business name of ZINN Water Well Drlg by (signature) Joseph A. Zinn

INSTRUCTIONS: Use typewriter or ball point pen. PLEASE PRESS FIRMLY and PRINT clearly. Please fill in blanks, underline or circle the correct answers. Send top three copies to Kansas Department of Health and Environment, Bureau of Water, Topeka, Kansas 66620-7320. Telephone: 913-296-5545. Send one to WATER WELL OWNER and retain one for your records.

6910921006-22