


1 LOCATION OF WATER WELL: Fraction NW 1/4 SW 1/4 NE 1/4 Section Number 23 Township Number T 7 S Range Number R 7 **E/W**  
 County: Pottawatomie

Distance and direction from nearest town or city street address of well if located within city?

Olsburg, Kansas

2 WATER WELL OWNER: Kansas Dept of Health and environment  
 RR#, St. Address, Box #: Forbes Field Board of Agriculture, Division of Water Resources  
 City, State, ZIP Code: Topeka, KS Application Number: N/A

3 LOCATE WELL'S LOCATION WITH AN "X" IN SECTION BOX:

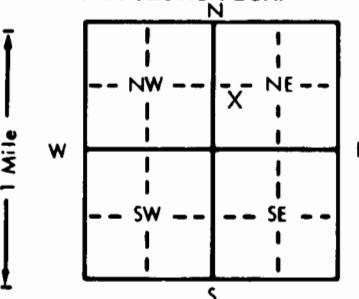

4 DEPTH OF COMPLETED WELL... 71.5 ft. ELEVATION: 1428.94  
 Depth(s) Groundwater Encountered 1. ft. 2. ft. 3. ft.  
 WELL'S STATIC WATER LEVEL 66.65 ft. below land surface measured on mo/day/yr 3/15/92  
 Pump test data: Well water was N/A ft. after hours pumping gpm  
 Est. Yield gpm: Well water was ft. after hours pumping gpm  
 Bore Hole Diameter .6.25 in. to ft., and in. to ft.  
 WELL WATER TO BE USED AS: 5 Public water supply 8 Air conditioning 11 Injection well  
 1 Domestic 3 Feedlot 6 Oil field water supply 9 Dewatering 12 Other (Specify below)  
 2 Irrigation 4 Industrial 7 Lawn and garden only **10 Monitoring well #4**  
 Was a chemical/bacteriological sample submitted to Department? Yes.....No. **X**..... If yes, mo/day/yr sample was submitted  
 Water Well Disinfected? Yes No **X**

5 TYPE OF BLANK CASING USED: 5 Wrought iron 8 Concrete tile CASING JOINTS: Glued Clamped  
 1 Steel 3 RMP (SR) 6 Asbestos-Cement 9 Other (specify below) Welded  
**2 PVC** 4 ABS 7 Fiberglass **Threaded**  
 Blank casing diameter 2' in. to 71.5 ft., Dia in. to ft., Dia in. to ft.  
 Casing height above land surface Flush in., weight lbs./ft. Wall thickness or gauge No. Sch. 40  
 TYPE OF SCREEN OR PERFORATION MATERIAL: **7 PVC** 10 Asbestos-cement  
 1 Steel 3 Stainless steel 5 Fiberglass 8 RMP (SR) 11 Other (specify)  
 2 Brass 4 Galvanized steel 6 Concrete tile 9 ABS 12 None used (open hole)  
 SCREEN OR PERFORATION OPENINGS ARE: 5 Gauzed wrapped 8 Saw cut 11 None (open hole)  
**1 Continuous slot** 3 Mill slot 6 Wire wrapped 9 Drilled holes  
 2 Louvered shutter 4 Key punched 7 Torch cut 10 Other (specify)  
 SCREEN-PERFORATED INTERVALS: From 51.5 ft. to 71.5 ft., From ft. to ft.  
 From ft. to ft., From ft. to ft.  
 GRAVEL PACK INTERVALS: From 48.0 ft. to 71.5 ft., From ft. to ft.  
 From ft. to ft., From ft. to ft.

6 GROUT MATERIAL: **1 Neat cement** 2 Cement grout **3 Bentonite** 4 Other  
 Grout Intervals: From 0 ft. to 45 ft., From 45 ft. to 48 ft., From ft. to ft.  
 What is the nearest source of possible contamination:  
**1 Septic tank** 4 Lateral lines 7 Pit privy **11 Fuel storage** 14 Abandoned water well  
 2 Sewer lines 5 Cess pool 8 Sewage lagoon 12 Fertilizer storage 15 Oil well/Gas well  
 3 Watertight sewer lines 6 Seepage pit 9 Feedyard 13 Insecticide storage 16 Other (specify below)

Direction from well? North

How many feet? 30'

FROM	TO	LITHOLOGIC LOG	FROM	TO	PLUGGING INTERVALS
0	28.5	Clay, orange-mottled, stiff, low plasticity, stiff, blocky, dry			
28.5	68.0	Limestone, yellowish-brown, highly weathered			
68.0	71.5	Shale, blue-gray, compenant			

7 CONTRACTOR'S OR LANDOWNER'S CERTIFICATION: This water well was **(1) constructed**, (2) reconstructed, or (3) plugged under my jurisdiction and was completed on (mo/day/year) 3/15/92 and this record is true to the best of my knowledge and belief. Kansas Water Well Contractor's License No. **468 549** This Water Well Record was completed on (mo/day/yr) 3/1/92 under the business name of J & R Drilling Services, Inc. by (signature) *Ray Coons*

INSTRUCTIONS: Use typewriter or ball point pen. PLEASE PRESS FIRMLY and PRINT clearly. Please fill in blanks, underline or circle the correct answers. Send top three copies to Kansas Department of Health and Environment, Bureau of Water, Topeka, Kansas 66620-0001. Telephone: 913-296-5545. Send one to WATER WELL OWNER and retain one for your records.