


1 LOCATION OF WATER WELL: Fraction SW 1/4 SW 1/4 NE 1/4 Section Number 23 Township Number T 7 S Range Number R 7 EW

Distance and direction from nearest town or city street address of well if located within city?  
Olsburg, Kansas

2 WATER WELL OWNER: Kansas Dept. of Health and Environment  
RR#, St. Address, Box #: Forbes Field Board of Agriculture, Division of Water Resources  
City, State, ZIP Code: Topeka, KS Application Number: n/a

3 LOCATE WELL'S LOCATION WITH AN "X" IN SECTION BOX:

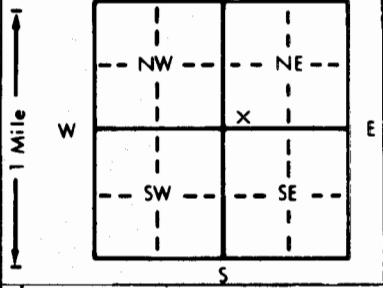

4 DEPTH OF COMPLETED WELL: 73.45 ft. ELEVATION:  
Depth(s) Groundwater Encountered 1. 60.21 ft. 2. ft. 3. ft.  
WELL'S STATIC WATER LEVEL: 60.21 ft. below land surface measured on mo/day/yr 3/16/92  
Pump test data: Well water was ft. after hours pumping gpm  
Est. Yield gpm: Well water was ft. after hours pumping gpm  
Bore Hole Diameter: 6.25 in. to 73.45 ft., and in. to ft.  
WELL WATER TO BE USED AS:  
5 Public water supply 8 Air conditioning 11 Injection well  
1 Domestic 3 Feedlot 6 Oil field water supply 9 Dewatering 12 Other (Specify below)  
2 Irrigation 4 Industrial 7 Lawn and garden only 10 Monitoring well MW 7  
Was a chemical/bacteriological sample submitted to Department? Yes No X; If yes, mo/day/yr sample was submitted  
Water Well Disinfected? Yes No X

5 TYPE OF BLANK CASING USED:  
1 Steel 3 RMP (SR) 5 Wrought iron 8 Concrete tile CASING JOINTS: Glued Clamped  
2 PVC 4 ABS 6 Asbestos-Cement 9 Other (specify below) Welded  
7 Fiberglass Threaded

Blank casing diameter 2 in. to 73.45 ft., Dia. in. to ft., Dia. in. to ft.  
Casing height above land surface: Flush in., weight lbs./ft. Wall thickness or gauge No.

TYPE OF SCREEN OR PERFORATION MATERIAL:  
1 Steel 3 Stainless steel 5 Fiberglass 8 RMP (SR) 10 Asbestos-cement  
2 Brass 4 Galvanized steel 6 Concrete tile 9 ABS 11 Other (specify) 12 None used (open hole)

SCREEN OR PERFORATION OPENINGS ARE:  
1 Continuous slot 3 Mill slot 5 Gauzed wrapped 8 Saw cut 11 None (open hole)  
2 Louvered shutter 4 Key punched 6 Wire wrapped 9 Drilled holes  
7 Torch cut 10 Other (specify)

SCREEN-PERFORATED INTERVALS: From 53.45 ft. to 73.45 ft., From ft. to ft.  
From ft. to ft., From ft. to ft.

GRAVEL PACK INTERVALS: From 50.0 ft. to 73.0 ft., From ft. to ft.  
From ft. to ft., From ft. to ft.

6 GROUT MATERIAL: 1 Neat cement 2 Cement grout 3 Bentonite 4 Other  
Grout intervals: From 0 ft. to 47 ft., From 47 ft. to 50 ft., From ft. to ft.

What is the nearest source of possible contamination:  
1 Septic tank 4 Lateral lines 7 Pit privy 11 Fuel storage 14 Abandoned water well  
2 Sewer lines 5 Cess pool 8 Sewage lagoon 12 Fertilizer storage 15 Oil well/Gas well  
3 Watertight sewer lines 6 Seepage pit 9 Feedyard 13 Insecticide storage 16 Other (specify below)  
Direction from well? East How many feet? 500

FROM	TO	LITHOLOGIC LOG	FROM	TO	PLUGGING INTERVALS
0	26.5	Clay, orange, mottled, low plasticity very stiff, inclusions, fractured, Blocky, dry			
26.5	73.0	Limestone, yellowish-brown, highly weathered and clay layers, dry			
73.0	73.45	Shale, blue-gray, fresh			

7 CONTRACTOR'S OR LANDOWNER'S CERTIFICATION: This water well was (1) constructed, (2) reconstructed, or (3) plugged under my jurisdiction and was completed on (mo/day/year) 3/14/92 and this record is true to the best of my knowledge and belief. Kansas Water Well Contractor's License No. 458-549 This Water Well Record was completed on (mo/day/yr) 4/2/92 under the business name of J & R Drilling Services, Inc. by (signature) Ray Coons