

WATER WELL PLUGGING RECORD Form WWC-5P

KSA 82a-1212 ID NO.

MW3


1 LOCATION OF WATER WELL: Fraction NW 1/4 NW 1/4 SW 1/4 NE 1/4 Section Number 23 Township Number T 07 S Range Number 07 E W
 County: Pottawatomie

Street/Rural Address of Well Location; if unknown, distance & direction from nearest town or intersection: If at owner's address, check here Northwest corner of 2nd & Elm, Olsburg, KS

Global Positioning Systems (GPS) information:
 Latitude: 39.43174 (in decimal degrees)
 Longitude: 96.61508 (in decimal degrees)
 Elevation: 1429.92 TOC
 Horizontal Datum: WGS84, NAD83, NAD27
 Collection Method:

2 WATER WELL OWNER: KDHE BER
 RR#, St. Address, Box #: 1000 SW Jackson St.
 City, State ZIP Code: Topeka, KS 66612

GPS unit (Make/Model: _____)
 Digital Map/Photo, Topographic Map, Land Survey
 Est. Accuracy: < 3 m, 3-5 m, 5-15 m, > 15 m

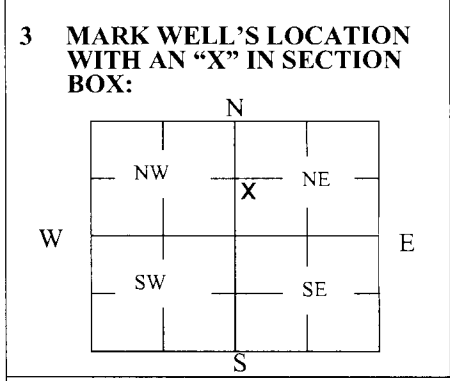

4 DEPTH OF WELL 74.60 ft.
 WELL'S STATIC WATER LEVEL 63.71 ft.
 WELL WAS USED AS:

Domestic Public Water Supply Dewatering
 Irrigation Oil Field Water Supply Monitoring
 Feedlot Domestic (Lawn & Garden) Injection Well
 Industrial Air Conditioning Other _____

Was a chemical/bacteriological sample submitted to Department? Yes No

5 TYPE OF BLANK CASING USED:

Steel RMP (SR) Wrought Fiberglass Other (Specify below) _____
 PVC ABS Asbestos-Cement Concrete Tile _____

Blank casing diameter 2 in. Was casing pulled? Yes No If yes, how much 3 ft
 Casing height above or below land surface 36 in.

6 GROUT PLUG MATERIAL: Neat cement Cement grout Bentonite Other _____

Grout Plug Intervals: From 3 ft. to 74.60 ft., From _____ ft. to _____ ft., From _____ ft. to _____ ft.


What is the nearest source of possible contamination:

Septic tank Seepage pit Fuel storage Other (specify below) _____
 Sewer lines Pit privy Fertilizer storage D&K Service U4-075-00141
 Watertight sewer lines Sewage lagoon Insecticide storage _____
 Lateral lines Feedyard Abandoned water well Direction from well? SE
 Cess pool Livestock pens Oil well/Gas well How many feet? 900

FROM	TO	PLUGGING MATERIALS	FROM	TO	PLUGGING MATERIALS
0	0.5	Concrete			
0.5	3	Compacted silt/clay			
3	74.60	Hydrated Bentonite chips			
					Former Conoco U4-075-13096

7 CONTRACTOR'S OR LANDOWNER'S CERTIFICATION: This water well was plugged under my jurisdiction and was completed on (mo/day/year) 2-21-19 and this record is true to the best of my knowledge and belief. Kansas Water Well Contractor's License No. 585. This Water Well Record was completed on (mo/day/year) 2-28-19 under the business name of Associated Environmental, Inc. by (signature) [Signature]

Send one white copy to Kansas Department of Health & Environment, Geology Section, 1000 SW Jackson Street, Ste. 420, Topeka, KS 66612-1367. Send one copy to WATER WELL OWNER and retain one for your records.
 Visit us at <http://www.kdheks.gov/waterwell/index.html> Telephone 785-296-5524.

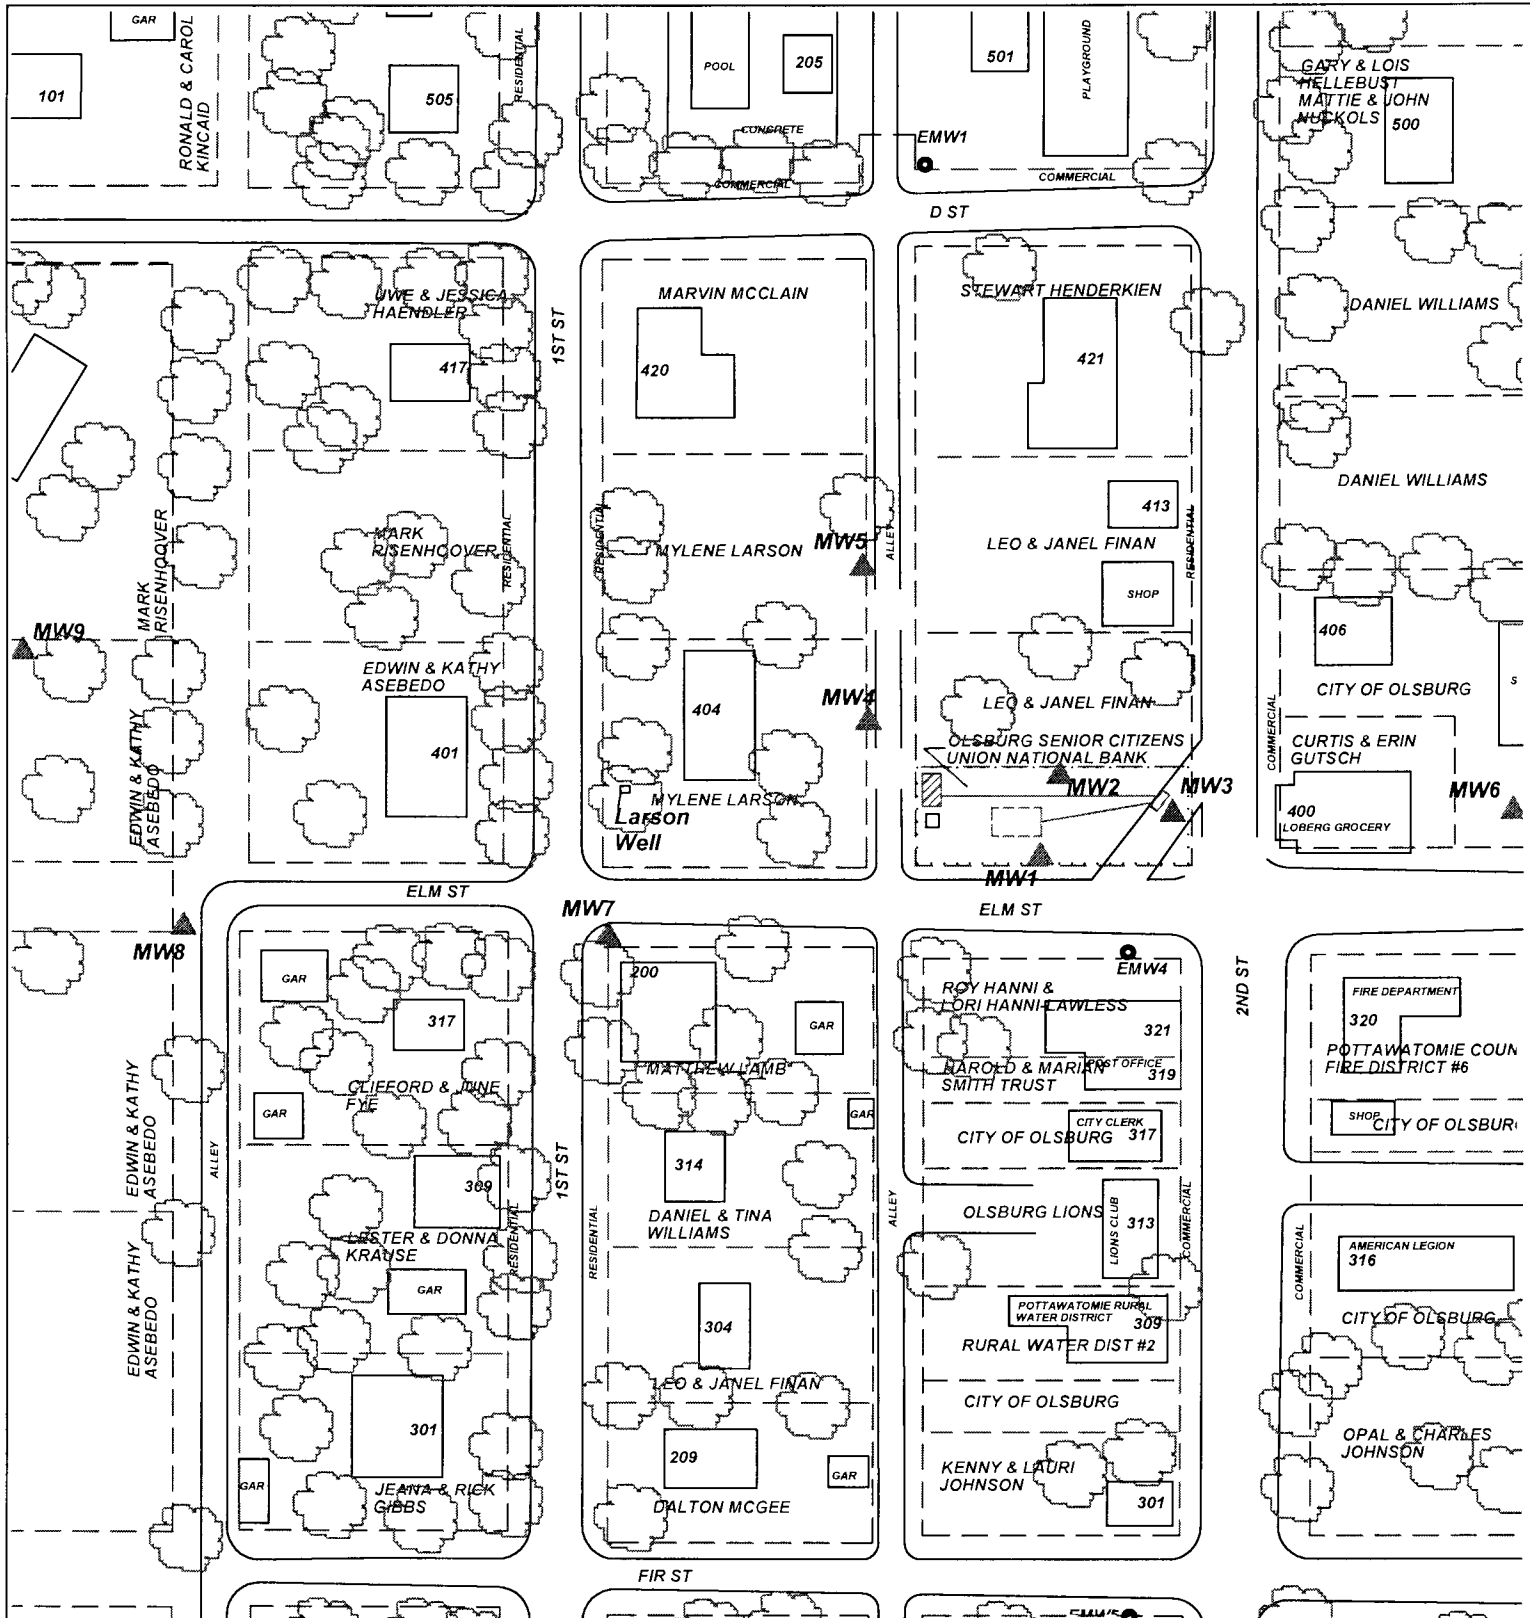

PROJECT: FORMER CONOCO

ADDRESS: NW CORNER OF 2ND & ELM


LOCATION: OLSBURG, KANSAS

DRAWN BY: B. STALNAKER **DATE:** 6/15/17








REVISED BY: B. STALNAKER **DATE:** 10/25/17


AEI JOB #: TM 228 **KDHE JOB #:** U4-075-13096

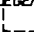TITLE:



ASSOCIATED ENVIRONMENTAL INC.

- LEGEND:**
-  = FORMER 8,000 GAL. GAS AST LOCATION
 -  = FORMER 1,000 GAL. GAS UST LOCATION
 -  = FORMER PUMP ISLAND AND LINES
 -  = MONITOR WELL
 -  = EXISTING MONITOR WELL (D&K SERVICE, U4-075-00141)
 -  = SUBJECT PROPERTY
 -  = PARCEL BOUNDARY

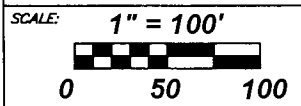

NOTES:
No basements observed within 500'.