

WATER WELL PLUGGING RECORD Form WWC-5P

KSA 82a-1212

ID NO.

MW4

1 LOCATION OF WATER WELL: Fraction NW 1/4 NW 1/4 SW 1/4 NE 1/4 Section Number 23 Township Number T 07 S Range Number 07 E W
 County: Pottawatomie


Street/Rural Address of Well Location; if unknown, distance & direction from nearest town or intersection: If at owner's address, check here Along alley west of Northwest corner of 2nd & Elm, Olsburg, KS

Global Positioning Systems (GPS) information:
 Latitude: 39.43209 (in decimal degrees)
 Longitude: 96.61568 (in decimal degrees)
 Elevation: 1426.15 TOC
 Horizontal Datum: WGS84, NAD83, NAD27
 Collection Method:

2 WATER WELL OWNER: KDHE BER
 RR#, St. Address, Box #: 1000 SW Jackson St.
 City, State ZIP Code: Topeka, KS 66612

GPS unit (Make/Model: _____)
 Digital Map/Photo, Topographic Map, Land Survey
 Est. Accuracy: < 3 m, 3-5 m, 5-15 m, > 15 m

3 MARK WELL'S LOCATION WITH AN "X" IN SECTION BOX:

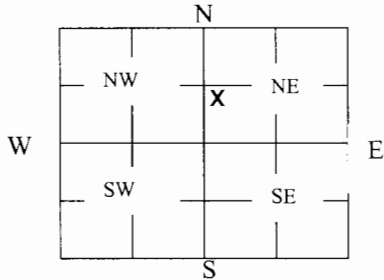

4 DEPTH OF WELL 74.20 ft.

WELL'S STATIC WATER LEVEL 61.01 ft

WELL WAS USED AS:

- Domestic
- Public Water Supply
- Dewatering
- Irrigation
- Oil Field Water Supply
- Monitoring
- Feedlot
- Domestic (Lawn & Garden)
- Injection Well
- Industrial
- Air Conditioning
- Other _____

Was a chemical/bacteriological sample submitted to Department? Yes No

5 TYPE OF BLANK CASING USED:

- Steel
- RMP (SR)
- Wrought
- Fiberglass
- Other (Specify below) _____
- PVC
- ABS
- Asbestos-Cement
- Concrete Tile

Blank casing diameter 2 in. Was casing pulled? Yes No If yes, how much 3 ft
 Casing height above or below land surface 36 in.

6 GROUT PLUG MATERIAL: Neat cement Cement grout Bentonite Other _____

Grout Plug Intervals: From 3 ft. to 74.20 ft., From _____ ft. to _____ ft., From _____ ft. to _____ ft.


What is the nearest source of possible contamination:

- Septic tank
- Seepage pit
- Fuel storage
- Other (specify below)
- Sewer lines
- Pit privy
- Fertilizer storage
- D&K Service U4-075-00141
- Watertight sewer lines
- Sewage lagoon
- Insecticide storage
- Lateral lines
- Feedyard
- Abandoned water well
- Direction from well? SE
- Cess pool
- Livestock pens
- Oil well/Gas well
- How many feet? ~900

FROM	TO	PLUGGING MATERIALS	FROM	TO	PLUGGING MATERIALS
0	3	Compacted silt/clay			
3	74.02	Hydrated Bentonite chips			
					Former Conoco U4-075-13096

7 CONTRACTOR'S OR LANDOWNER'S CERTIFICATION: This water well was plugged under my jurisdiction and was completed on (mo/day/year) 2-21-19 and this record is true to the best of my knowledge and belief. Kansas Water Well Contractor's License No. 585. This Water Well Record was completed on (mo/day/year) 2-28-19 under the business name of Associated Environmental, Inc. by (signature) [Signature]

Send one white copy to Kansas Department of Health & Environment, Geology Section, 1000 SW Jackson Street, Ste. 420, Topeka, KS 66612-1367. Send one copy to WATER WELL OWNER and retain one for your records.
 Visit us at <http://www.kdheks.gov/waterwell/index.html> Telephone 785-296-5524.

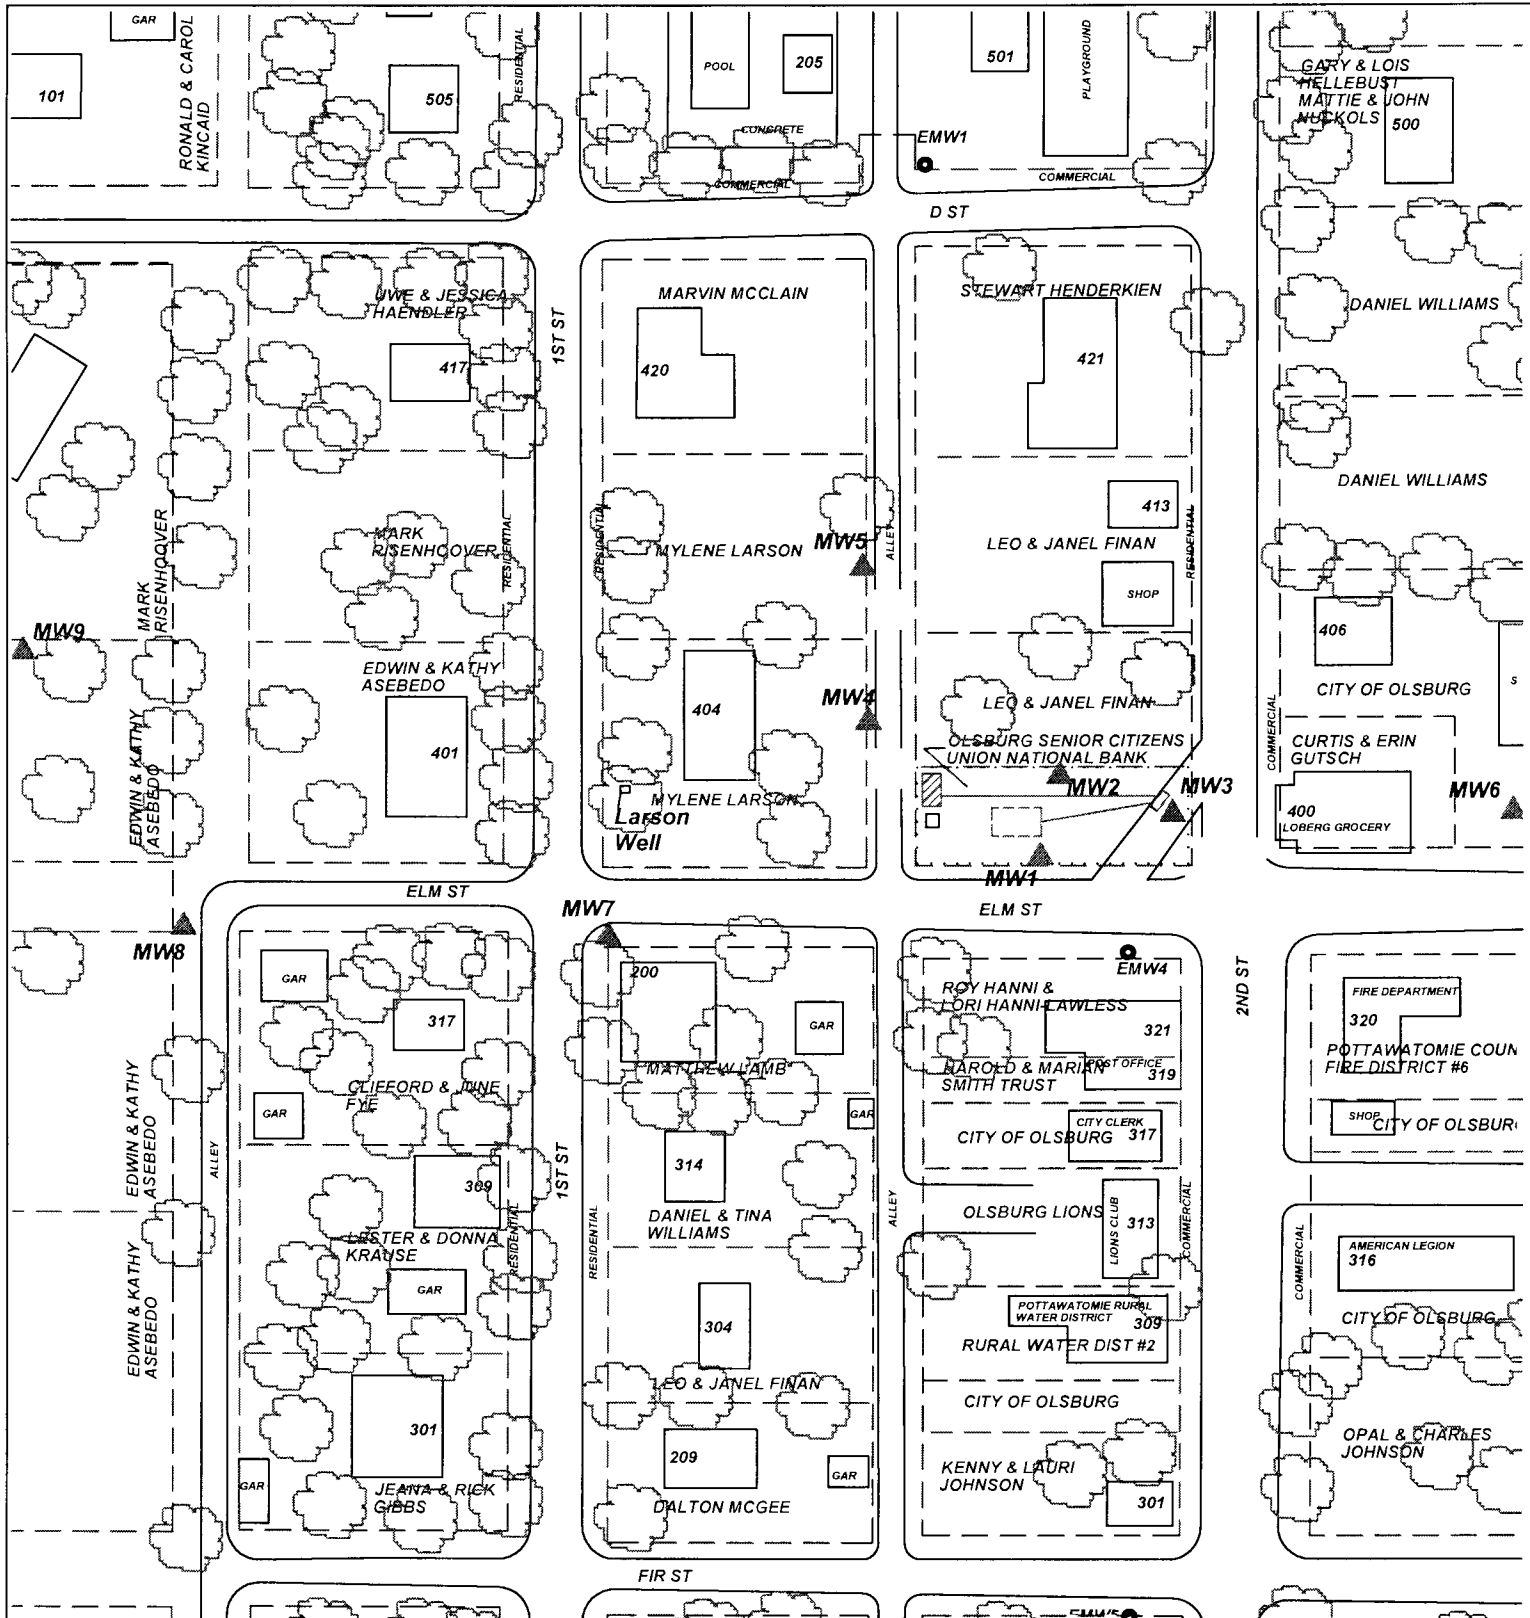

PROJECT: **FORMER CONOCO**

ADDRESS: **NW CORNER OF 2ND & ELM**


LOCATION: **OLSBURG, KANSAS**

DRAWN BY: **B. STALNAKER** DATE: **6/15/17**








REVISED BY: **B. STALNAKER** DATE: **10/25/17**


AEI JOB #: **TM 228** KDHE JOB #: **U4-075-13096**

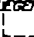TITLE:



ASSOCIATED ENVIRONMENTAL INC.

- LEGEND:
-  = FORMER 8,000 GAL. GAS AST LOCATION
 -  = FORMER 1,000 GAL. GAS UST LOCATION
 -  = FORMER PUMP ISLAND AND LINES
 -  = MONITOR WELL
 -  = EXISTING MONITOR WELL (D&K SERVICE, U4-075-00141)
 -  = SUBJECT PROPERTY
 -  = PARCEL BOUNDARY

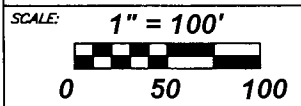

NOTES:
No basements observed within 500'.