

LOCATION OF WATER WELL:

Fraction

Section Number

Township Number

Range Number

County:

Pott

NE 1/4

SE 1/4

SE 1/4

36

T 7 S

R

8 EW

Distance and direction from nearest town or city street address of well if located within city?

From West Morkland Go 5 miles South 1 mile to LAZY CREEK & 60 East 1/2 mile

WATER WELL OWNER:

Gory Skidmore

RR#, St. Address, Box #:

11675 Glenwood Ln.


City, State, ZIP Code

ST George, KS 66535

Board of Agriculture, Division of Water Resources

Application Number:

LOCATE WELL'S LOCATION WITH AN "X" IN SECTION BOX:

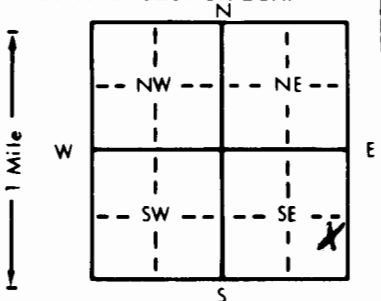

DEPTH OF COMPLETED WELL: 120 ft. ELEVATION:

Depth(s) Groundwater Encountered 1. 75 ft. 2. ft. 3. ft.

WELL'S STATIC WATER LEVEL 7.0 ft. below land surface measured on mo/day/yr

Pump test data: Well water was ft. after hours pumping gpm

Est. Yield 8 gpm: Well water was ft. after hours pumping gpm

Bore Hole Diameter 9 in. to 120 ft. and in. to ft.

WELL WATER TO BE USED AS: 5 Public water supply 8 Air conditioning 11 Injection well

1 Domestic 3 Feedlot 6 Oil field water supply 9 Dewatering 12 Other (Specify below)

2 Irrigation 4 Industrial 7 Lawn and garden only 10 Monitoring well

Was a chemical/bacteriological sample submitted to Department? Yes No If yes, mo/day/yr sample was submitted

Water Well Disinfected? Yes No

TYPE OF BLANK CASING USED:

1 Steel

3 RMP (SR)

5 Wrought iron

8 Concrete tile

CASING JOINTS: Glued Clamped

2 PVC

4 ABS

6 Asbestos-Cement

9 Other (specify below)

Welded

Blank casing diameter 5 in. to 100 ft. Dia

Casing height above land surface 2 in. weight 5.440 lbs./ft. Wall thickness or gauge No.

TYPE OF SCREEN OR PERFORATION MATERIAL:

1 Steel

3 Stainless steel

5 Fiberglass

7 PVC

10 Asbestos-cement

2 Brass

4 Galvanized steel

6 Concrete tile

9 ABS

11 Other (specify)

12 None used (open hole)

SCREEN OR PERFORATION OPENINGS ARE:

1 Continuous slot

3 Mill slot

5 Gauzed wrapped

8 Saw cut

11 None (open hole)

2 Louvered shutter

4 Key punched

6 Wire wrapped

9 Drilled holes

10 Other (specify)

SCREEN-PERFORATED INTERVALS: From 100 ft. to 120 ft. From ft. to ft. From ft. to ft. From ft. to ft.

GRAVEL PACK INTERVALS: From 25 ft. to 120 ft. From ft. to ft. From ft. to ft. From ft. to ft.

GROUT MATERIAL:

1 Neat cement

2 Cement grout

3 Bentonite

4 Other

Grout Intervals: From 0 ft. to 25 ft. From ft. to ft. From ft. to ft. From ft. to ft.

What is the nearest source of possible contamination:

1 Septic tank

4 Lateral lines

7 Pit privy

10 Livestock pens

14 Abandoned water well

2 Sewer lines

5 Cess pool

8 Sewage lagoon

11 Fuel storage

15 Oil well/Gas well

3 Watertight sewer lines

6 Seepage pit

9 Feedyard

12 Fertilizer storage

16 Other (specify below)

13 Insecticide storage

Direction from well?

How many feet?

FROM	TO	LITHOLOGIC LOG	FROM	TO	PLUGGING INTERVALS
0	1	Top Soil			
1	19	Brown Shale			
19	23	Limestone			
23	30	Grey Shale			
30	50	Brown Shale			
50	58	Limestone			
58	62	Grey Shale			
62	73	Brown Shale (Water)			
73	77	Limestone			
77	81	Brown Shale			
81	84	Limestone			
84	98	Brown Shale			
98	102	Limestone			
102	111	Brown Shale			
111	120	Grey Shale			

CONTRACTOR'S OR LANDOWNER'S CERTIFICATION: This water well was (1) constructed, (2) reconstructed, or (3) plugged under my jurisdiction and was completed on (mo/day/year) 7/15/96 and this record is true to the best of my knowledge and belief. Kansas

Water Well Contractor's License No. 451 This Water Well Record was completed on (mo/day/yr) 8/20/96

under the business name of HOLDMAN WELL DRILLING by (signature) Craig J. Enders