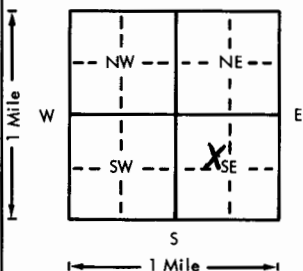


USE TYPEWRITER OR BALL
POINT PEN-PRESS FIRMLY,
PRINT CLEARLY.

WATER WELL RECORD
KSA 82a-1201-1215

Kansas Department of Health and
Environment-Division of Environment
(Water well Contractors)
Topeka, Kansas 66620

1. Location of well:		County <u>Pott</u>	Fraction <u>SE 1/4 NW 1/4 SE 1/4</u>	Section number <u>15</u>	Township number <u>T 77S</u>	Range number <u>R 8E</u>
2. Distance and direction from nearest town or city: <u>M. St. Black 5-Lot-9-10 + S-2' of lot 11</u>			3. Owner of well: <u>RICK WEEKS</u> or street: <u>Main</u> City, state, zip code: <u>Fostoria, Kans. 66426</u>			
4. Locate with "X" in section below:		Sketch map:		6. Bore hole dia. <u>8</u> in. Completion date <u>6-4-77</u> Well depth <u>110</u> ft.		
				7. <input checked="" type="checkbox"/> Cable tool <input type="checkbox"/> Rotary <input type="checkbox"/> Driven <input type="checkbox"/> Dug <input type="checkbox"/> Hollow rod <input type="checkbox"/> Jetted <input type="checkbox"/> Bored <input type="checkbox"/> Reverse rotary		
5. Type and color of material		From	To	8. Use: <input checked="" type="checkbox"/> Domestic <input type="checkbox"/> Public supply <input type="checkbox"/> Industry <input type="checkbox"/> Irrigation <input type="checkbox"/> Air conditioning <input type="checkbox"/> Stock <input type="checkbox"/> Lawn <input type="checkbox"/> Oil field water <input type="checkbox"/> Other		
<u>Dirt Black</u>		<u>0</u>	<u>5</u>	9. Casing: Material <u>PVC</u> Height: Above or below Threaded <u>Ghee</u> Surface <u>24</u> in. RMP <u>PVC</u> Weight <u>10</u> lbs./ft. Dia. <u>5</u> in. to <u>110</u> ft. depth Wall thickness: inches or Dia. <u>5</u> in. to <u>110</u> ft. depth gage No. <u>Sch 40</u>		
<u>Clay yellow</u>		<u>5</u>	<u>40</u>	10. Screen: Manufacturer's name <u>Pumpco</u> Type <u>PVC</u> Dia. <u>5"</u> Slot/gauze <u>#80</u> Length <u>30'</u> Set between <u>80</u> ft. and <u>110</u> ft. Gravel pack? <u>yes</u> Size range of material <u>#6-#10</u>		
<u>Lime Rock yellow</u>		<u>40</u>	<u>50</u>	11. Static water level: <u>70</u> mo./day/yr. <u>70</u> ft. below land surface Date <u>6-4-77</u>		
<u>Shale Blue + Hard</u>		<u>50</u>	<u>70</u>	12. Pumping level below land surfaces: ft. after hrs. pumping g.p.m. ft. after hrs. pumping g.p.m. Estimated maximum yield g.p.m.		
<u>Lime Rock White + Flint Blue</u>		<u>70</u>	<u>90</u>	13. Water sample submitted: <u>yes</u> mo./day/yr. <u>yes</u> <u>X</u> No Date		
<u>Shale Blue</u>		<u>90</u>	<u>95</u>	14. Well head completion: Pitless adapter _____ Inches above grade		
<u>" Brown</u>		<u>95</u>	<u>105</u>	15. Well grouted? <u>yes</u> With: <u>X</u> Neat cement <input type="checkbox"/> Bentonite <input type="checkbox"/> Concrete Depth: From <u>4</u> ft. to <u>14</u> ft.		
<u>" Gray</u>		<u>105</u>	<u>110</u>	16. Nearest source of possible contamination: <u>Septic</u> ft. <u>200'</u> Direction <u>E</u> Type <u>Tank</u> Well disinfected upon completion? <u>X</u> Yes <input type="checkbox"/> No		
				17. Pump: <u>X</u> Not installed Manufacturer's name _____ Model number _____ HP _____ Volts _____ Length of drop pipe _____ ft. capacity _____ g.p.m. Type: <input type="checkbox"/> Submersible <input type="checkbox"/> Turbine <input type="checkbox"/> Jet <input type="checkbox"/> Reciprocating <input type="checkbox"/> Centrifugal <input type="checkbox"/> Other		
18. Elevation: <u>1465</u>		19. Remarks: <u>Cement slab to be poured by</u> <u>customer 4' x 4' - 4" thick</u> <u>Rick & Weeks</u> <u>By Louise Weeks</u>		20. Water well contractor's certification: This well was drilled under my jurisdiction and this report is true to the best of my knowledge and belief. <u>Harpers Drilg Serv. 176A</u> Business name <u>Blue Rapids Ks.</u> License No. _____ Address _____ Signed <u>C.E. Harper</u> Date <u>6-4-77</u> Authorized representative		

Forward the white, blue and pink copies to the Department of Health and Environment

Form WWC-5