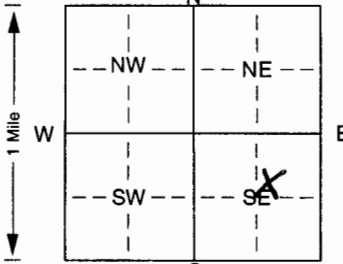


1 LOCATION OF WATER WELL:	Fraction	Section Number	Township Number	Range Number
County: <u>POTTAWATOMIE</u>	<u>SW</u> $\frac{1}{4}$ <u>NE</u> $\frac{1}{4}$ <u>SE</u> $\frac{1}{4}$	<u>8</u>	T <u>7</u> S	R <u>9</u> <u>EW</u>

Distance and direction from nearest town or city street address of well if located within city?

FROM WESTMINSTERLAND: 4.5 MILES NORTH, 1 MILE WEST, 3/4 SOUTH

2 WATER WELL OWNER: <u>ERIC MARTEN</u>	Board of Agriculture, Division of Water Resources
RR#, St. Address, Box #: <u>4900 LAURELAND DR</u>	Application Number: _____
City, State, ZIP Code: <u>MOHAWITH, KS. 66503</u>	

3 LOCATE WELL'S LOCATION WITH AN "X" IN SECTION BOX:	4 DEPTH OF COMPLETED WELL: <u>115</u> ft. ELEVATION: _____
	Depth(s) Groundwater Encountered 1. <u>78</u> ft. 2. _____ ft. 3. _____ ft.
	WELL'S STATIC WATER LEVEL <u>56</u> ft. below land surface measured on mo/day/yr <u>7/12/02</u>
	Pump test data: Well water was _____ ft. after _____ hours pumping _____ gpm
	Est. Yield <u>10</u> gpm: Well water was _____ ft. after _____ hours pumping _____ gpm
	Bore Hole Diameter: <u>8.75</u> in. to <u>115</u> ft. and _____ in. to _____ ft.
	WELL WATER TO BE USED AS: 5 Public water supply 8 Air conditioning 11 Injection well
	<u>1 Domestic</u> 3 Feedlot 6 Oil field water supply 9 Dewatering 12 Other (Specify below)
	2 Irrigation 4 Industrial 7 Domestic (lawn & garden) 10 Monitoring well
	Was a chemical/bacteriological sample submitted to Department? Yes. _____ No. <u>X</u> ; If yes, mo/day/yr sample was submitted
	Water Well Disinfected? Yes <u>X</u> No

5 TYPE OF BLANK CASING USED:	5 Wrought iron	8 Concrete tile	CASING JOINTS: Glued <u>X</u> Clamped
1 Steel	3 RMP (SR)	6 Asbestos-Cement	9 Other (specify below)
<u>2 PVC</u>	4 ABS	7 Fiberglass	Welded
			Threaded
Blank casing diameter <u>5</u> in. to <u>75</u> ft. Dia <u>5</u> in. to <u>105</u> ft. Dia _____ in. to _____ ft.			
Casing height above land surface <u>24</u> in., weight _____ lbs./ft. Wall thickness or gauge No. <u>SDR 26</u>			
TYPE OF SCREEN OR PERFORATION MATERIAL:			
1 Steel	3 Stainless steel	5 Fiberglass	<u>10 Asbestos-cement</u>
2 Brass	4 Galvanized steel	6 Concrete tile	8 RMP (SR)
			9 ABS
			11 Other (specify)
			12 None used (open hole)
SCREEN OR PERFORATION OPENINGS ARE:	5 Gauzed wrapped	8 Saw cut	11 None (open hole)
1 Continuous slot	<u>3 Mill slot</u>	6 Wire wrapped	9 Drilled holes
2 Louvered shutter	4 Key punched	7 Torch cut	10 Other (specify) _____ ft.
SCREEN-PERFORATED INTERVALS: From <u>75</u> ft. to <u>105</u> ft. From _____ ft. to _____ ft.			
GRAVEL PACK INTERVALS: From <u>23</u> ft. to <u>115</u> ft. From _____ ft. to _____ ft.			

6 GROUT MATERIAL:	1 Neat cement	2 Cement grout	<u>3 Bentonite</u>	4 Other
Grout Intervals: From <u>0</u> ft. to <u>23</u> ft. From _____ ft. to _____ ft.				
What is the nearest source of possible contamination:				
1 Septic tank	4 Lateral lines	7 Pit privy	10 Livestock pens	14 Abandoned water well
2 Sewer lines	5 Cess pool	8 Sewage lagoon	11 Fuel storage	15 Oil well/Gas well
3 Watertight sewer lines	6 Seepage pit	9 Feedyard	12 Fertilizer storage	<u>16 Other (specify below)</u>
Direction from well?			13 Insecticide storage	<u>NEW CONSTRUCTION</u>
			How many feet?	

FROM	TO	LITHOLOGIC LOG	FROM	TO	PLUGGING INTERVALS
0	2	SOIL			
2	3	LIMESTONE			
3	20	SHALE TAN GRADES TO GRAY			
20	23	LIMESTONE, GRAY			
23	28	SHALE GRAY			
28	31	LIMESTONE TAN			
31	54	SHALE, GRAY			
54	61	LIMESTONE WEATHERED TAN			
61	74	LIMESTONE, SHALE, GRAY			
74	78	LIMESTONE H ₂ O			
78	84	MUDSTONE GRAY			
84	106	SHALE GRAY			
106	114	MUDSTONE			
114	115	SHALE GRAY			

7 CONTRACTOR'S OR LANDOWNER'S CERTIFICATION: This water well was <u>1</u> constructed, (2) reconstructed, or (3) plugged under my jurisdiction and was completed on (mo/day/year) <u>7/12/02</u> and this record is true to the best of my knowledge and belief. Kansas Water Well Contractor's Licence No. <u>585</u> This Water Well Record was completed on (mo/day/yr) <u>8/2/02</u> under the business name of <u>AREP</u> by (signature) <u>[Signature]</u>
