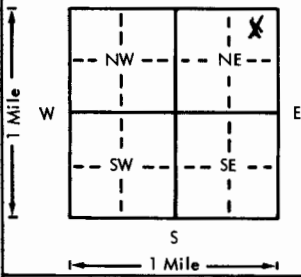


USE TYPEWRITER OR BALL
POINT PEN-PRESS FIRMLY,
PRINT CLEARLY.

WATER WELL RECORD
KSA 82a-1201-1215

Kansas Department of Health and
Environment-Division of Environment
(Water well Contractors)
Topeka, Kansas 66620

1. Location of well:		County Pollawatic	Fraction NE 1/4 NE 1/4 NE 1/4	Section number 11	Township number T 7 S	Range number R 9 E
2. Distance and direction from nearest town or city:		Blaine Mo.		3. Owner of well: Chester Smith		
Street address of well location if in city: 2 S. 1 1/2 E.				R.R. or street: RT-1		
				City, state, zip code: Blaine Kans. 66410		
4. Locate with "X" in section below:		Sketch map:		6. Bore hole dia. 8 in. Completion date 2-6-76		
				Well depth 104 ft.		
5. Type and color of material		From		To		7. <input checked="" type="checkbox"/> Cable tool <input type="checkbox"/> Rotary <input type="checkbox"/> Driven <input type="checkbox"/> Dug
Clean Out & Recase						<input type="checkbox"/> Hollow rod <input type="checkbox"/> Jetted <input type="checkbox"/> Bored <input type="checkbox"/> Reverse rotary
No Log						8. Use: <input checked="" type="checkbox"/> Domestic <input type="checkbox"/> Public supply <input type="checkbox"/> Industry
						<input type="checkbox"/> Irrigation <input type="checkbox"/> Air conditioning <input type="checkbox"/> Stock
						<input type="checkbox"/> Lawn <input type="checkbox"/> Oil field water <input type="checkbox"/> Other
						9. Casing: Material PVC Height: Above or below
						Threaded <input type="checkbox"/> Welded <input checked="" type="checkbox"/> Surface 78 in.
						RMP <input type="checkbox"/> PVC <input checked="" type="checkbox"/> Weight <input type="checkbox"/> lbs./ft.
						Dia. 5 in. to 104 ft. depth Wall Thickness: inches or
						Dia. <input type="checkbox"/> in. to <input type="checkbox"/> ft. depth gage No. 200
						10. Screen: Manufacturer's name Jess & Howell Casing Co.
						Type PVC Dia. 5
						Slot/gauge 1/16 Length 20
						Set between 84 ft. and 104 ft.
						<input type="checkbox"/> ft. and <input type="checkbox"/> ft.
						Gravel pack? Yes Size range of material 1/2 - 3/4
						11. Static water level: <input type="checkbox"/> mo./day/yr.
						70 ft. below land surface Date 2-6-76
						12. Pumping level below land surfaces:
						<input type="checkbox"/> ft. after <input type="checkbox"/> hrs. pumping <input type="checkbox"/> g.p.m.
						<input type="checkbox"/> ft. after <input type="checkbox"/> hrs. pumping <input type="checkbox"/> g.p.m.
						Estimated maximum yield <input type="checkbox"/> g.p.m.
						13. Water sample submitted: <input type="checkbox"/> mo./day/yr.
						<input type="checkbox"/> Yes <input checked="" type="checkbox"/> No Date <input type="checkbox"/>
						14. Well head completion:
						<input checked="" type="checkbox"/> Pitless adapter 18 inches above grade
						15. Well grouted? Yes
						With: <input checked="" type="checkbox"/> Neat cement <input type="checkbox"/> Bentonite <input type="checkbox"/> Concrete
						Depth: From 4 ft. to 15 ft.
						16. Nearest source of possible contamination:
						ft. 200 Direction South Type Stock Pens
						Well disinfected upon completion? <input checked="" type="checkbox"/> Yes <input type="checkbox"/> No
						17. Pump: <input checked="" type="checkbox"/> Not installed
						Manufacturer's name <input type="checkbox"/>
						Model number <input type="checkbox"/> HP <input type="checkbox"/> Volts <input type="checkbox"/>
						Length of drop pipe <input type="checkbox"/> ft. capacity <input type="checkbox"/> g.p.m.
						Type:
						<input type="checkbox"/> Submersible <input type="checkbox"/> Turbine
						<input type="checkbox"/> Jet <input type="checkbox"/> Reciprocating
						<input type="checkbox"/> Centrifugal <input type="checkbox"/> Other
18. Elevation:		19. Remarks:		20. Water well contractor's certification:		
Topography:		Concrete Slab to be Poured by		This well was drilled under my jurisdiction and this report		
<input checked="" type="checkbox"/> Hill		Land owner His Agreement		is true to the best of my knowledge and belief.		
<input checked="" type="checkbox"/> Slope				Hughes & Sons 116		
<input type="checkbox"/> Upland				Business name Blaine License No.		
<input type="checkbox"/> Valley				Address Blaine		
				Signed D. B. Hughes Date 2-6-76		
				Authorized representative		