

CORRECTION(S) TO WATER WELL RECORD (WWC-5)
(to rectify lacking or incorrect information)

County: Pottawatomie

Location listed as:

Location changed to:

Section-Township-Range: 28-08-10 E

28-85-10 E

Fraction (1/4 1/4 1/4): SE NW SE

SE SW NE SE

Other changes: Initial statements: _____

Changed to: _____

Comments: _____

verification method: Latitude & longitude, KGS' "LEO" conversion tool, and mapping tool & aerial photos on KGS website.

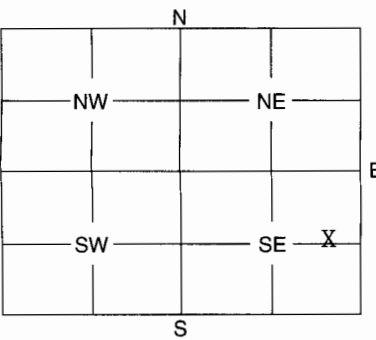
initials: DRL date: 5/21/2009

submitted by: Kansas Geological Survey, Data Resources Library, 1930 Constant Ave., Lawrence, KS 66047-3726
to: Kansas Dept of Health & Environment, Bureau of Water, 1000 SW Jackson, Suite 420, Topeka, KS 66612-1367.

1	LOCATION OF WATER WELL:	Fraction	Section Number	Township Number	Range Number
	County: Pottawatomie	SE 1/4 NW 1/4 SE 1/4	28	08	10 EW

Distance and direction from nearest town or city street address of well if located within city? 39° 19.355N
 3.5 Miles N, 1 mile East, 4/10 mile N of Louisville Kansas 66547 096° 17.932W

2	WATER WELL OWNER: Tommie Sue Burgess	Board of Agriculture, Division of Water Resources
	RR #, St. Address, Box #: 10620 Adams Creek Rd.	Application Number:
	City, State, ZIP Code : Wamego, KS 66547	

3	MARK WELL'S LOCATION WITH AN "X" IN SECTION BOX:	4	DEPTH OF WELL 18.5 ft.	
			WELL'S STATIC WATER LEVEL 6.5 ft.	
			WELL WAS USED AS:	
		<input checked="" type="checkbox"/> 1 Domestic	5 Public Water Supply	9 Dewatering
		<input checked="" type="checkbox"/> 2 Irrigation	6 Oil Field Water Supply	10 Monitoring Well
		3 Feedlot	7 Domestic (Lawn & Garden)	11 Injection Well
		4 Industrial	8 Air Conditioning	12 Other
		Was a chemical / bacteriological sample submitted to Department? Yes No <input checked="" type="checkbox"/>		
		If yes, mo/day/yr sample was submitted		
		Water Well Disinfected: Yes <input checked="" type="checkbox"/> No		

5	TYPE OF BLANK CASING USED:
	1 Steel 3 RMP (SR) 5 Wrought 7 Fiberglass 9 Other (Specify below)
	2 PVC 4 ABS 6 Asbestos-Cement 8 Concrete Tile
	Blank casing diameter in. Was casing pulled? Yes No If yes, how much
	Casing height above or below land surface in.

6	GROUT PLUG MATERIAL: 1 Neat cement 2 Cement grout 3 Bentonite 4 Other
	GROUT PLUG INTERVALS: From ... 4.5 ft. to ... 5.0 ft., From ft. to ft., From to ft.
	What is the nearest source of possible contamination:
	1 Septic tank 6 Seepage pit 11 Fuel storage 16 Other (specify below)
	2 Sewer lines 7 Pit privy 12 Fertilizer storage
	3 Watertight sewer lines 8 Sewage lagoon 13 Insecticide storage
	4 Lateral lines 9 Feedyard 14 Abandoned water well
	5 Cess pool 10 Livestock pens 15 Oil well/Gas well
	Direction from well? <u>In lot</u> How many feet? <u>0</u>

FROM	TO	PLUGGING MATERIALS
18.5	6.5	Clean fill sand
6.5	5.0	Clean soil & Rock
5.0	4.5	Sodium Bentonite
4.5	+1.0	Clean soil

7	CONTRACTOR'S OF LANDOWNER'S CERTIFICATION: This water well was plugged under my jurisdiction and was completed on (mo/day/year) <u>04/15/2009</u> and this record is true to the best of my knowledge and belief. Kansas Water Well Contractor's License No. This Water Well Record was completed on (mo/day/year) <u>04/15/2009</u> under the business name of <u>Pottawatomie County Environmental Health</u> by (signature) <u>Scott Schwian, R.S. Sanitarian</u>
---	---

INSTRUCTIONS: Use typewriter or ball point pen. Please press firmly and print clearly. Please fill in blanks, underline or circle the correct answers. Send top three copies to Kansas Department of Health and Environment, Bureau of Water, Geology Section, 1000 SW Jackson St., Ste. 420, Topeka, Kansas 66612-1367. Telephone: 785/296-5522. Send one to Water Well Owner and retain one for your records.